

MISSISSIPPI DEPARTMENT OF NATURAL RESOURCES

Bureau of Land and Water Resources

Southport Mall

P.O. Box 10631

CODED

Jackson, Mississippi 39209

WATER WELL DRILLERS LOG

Pike
A 205

8-25

186 Layne Central Co.

Pike

date well completed

firm name

county well located

LANDOWNER: Noah Pike
Water Association
Summitt, MS
(mailing address)

WELL LOCATION:
sec. 28 T. 4 N. R. 7 E.
4 miles W of Summitt
(distance) (direction) (nearest town)

WELL PURPOSE: W.A.
(home, irrigation, municipal, industrial)

- WELL COMPLETION DATA:
- (1) diameter (inches) 14"
 - (2) total depth (feet) 196'
 - (3) static water level (feet) 45' below above top of ground.
 - (4) casing Steel, 145',
(material) (depth)
 - 14" if telescope see back.
(size) 150' of 10"
 - (5) screen 40'6", 145'
(length) (depth to top)
 - 10", Stainless Steel
(size) (material)
 - (6) pump 30 400
(HP) (yield gpm)
 - Electric
(type power)
 - (7) electric log yes
(yes or no)
 - Layne Central
(organization running log)
 - (8) how well bottom plugged Cement

description of formations encountered	from	to
Clay	0'	10'
Sand & Pea Gravel	10'	110'
Clay	110'	130'
Sand	130'	198'
Clay	198'	304'
Sand & Clay	304'	335'
Sandy Clay	335'	415'
Clay	415'	447'
Sand	447'	547'
Clay	547'	695'
Sand & Clay	695'	734'
Clay	734'	854'
Sand	854'	928'
Clay	928'	987'
Sand	987'	1005'
Sand Clay	1005'	1069'
Sand	1069'	1150'
Sandy Clay	1150'	1196'


RECEIVED

FEB 06 1987

Department of Natural Resources
Bureau of Land & Water Resources

DRILLERS REMARKS:

If well telescopes please sketch and show depths.

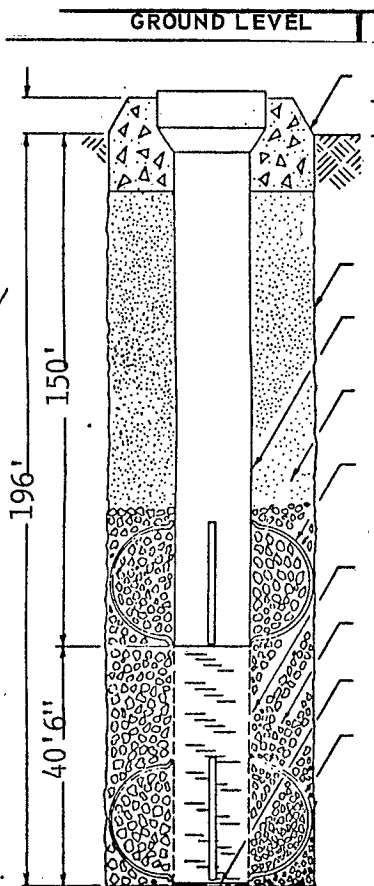

SECTION _____

Please indicate well location X.

ADDITIONAL INFORMATION

If more than one screen, show locations of each on sketch.