

**MISSISSIPPI DEPARTMENT OF ENVIRONMENTAL  
QUALITY**

Office of Land and Water Resources

P. O. Box 10631  
Jackson, MS 39289-0631  
**WATER WELL DRILLERS LOG**

COUNTY WELL LOCATED <b>PIKE</b>	
WELL NUMBER #4 <b>A206</b>	CODED <input checked="" type="checkbox"/>
<b>7-3-99</b>	
DATE WELL COMPLETED <b>7-3-99</b>	

PERMIT NUMBER
NAME OF DRILLING FIRM <b>Griner Drilling Service</b>

NAME & MAILING ADDRESS OF LANDOWNER <b>NORTH PIKE WATER ASSOCIATION</b>			
<b>P. O. BOX 445</b>			
<b>SUMMIT, MS 39666</b>			
WELL LOCATION:	SEC	TOWNSHIP	RANGE
	<u>28</u>	<u>04</u> (N)	<u>07</u> (W)
DISTANCE	DIRECTION		NEAREST TOWN
<u>2</u> Miles	<u>WEST</u> of		<u>HWY. 51</u>
OTHER LANDMARK <b>AT SUMMIT</b>			
WELL PURPOSE: Home, Irrigation, Municipal, Industrial, Fish Pond, etc. <b>MUNICIPAL</b>			

PUMP DATA		
PUMP TYPE (Circle One): (Submersible, ) Turbine, Jet <u>Flowing Well</u> , Other (Describe) _____		
POWER TYPE (Circle One): (Electric) Tractor, Diesel, Gasoline, <u>25</u> Butane, Other (Describe) _____ H/P _____		
Pump Capacity (GPM)	No. of Stages	Setting Depth
<u>400</u>	<u>3</u>	<u>165</u> FT.
PUMP TEST		
Well yielded <u>402</u> GPM with a drawdown of <u>39.47</u> ft. after <u>4</u> hours of pumping		

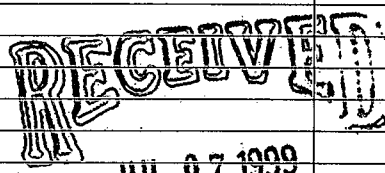
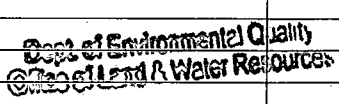
WELL DATA		
Well Depth	Casing Diameter (In.)	Casing Length (Ft.)
<u>256</u>	<u>16</u>	<u>210</u>
Type of Casing	Hole Depth	Depth to Static Water Level
<u>COATED</u>	<u>300'</u>	<u>80.35</u>
TYPE OF COMPLETION: (Circle One or More): (Gravel Packed, Underreamed, Telescoped, Natural Development, Open Hole, Other (Describe) _____)		
WELL GROUTED TO A DEPTH OF <u>210</u> FEET Type Grout (circle one): Cement, Bentonite, or(Mix)		

LOG DATA	
TYPE OF LOG RUN (Circle One): (Electric, Gamma Ray) Density, Sonic, Neutron, Other (Describe) _____	
Name of Organization Running Log	

SCREEN DATA		
Diameter - Inches	Length - Feet	Slot Size - Inches
<u>10</u>	<u>40'</u>	<u>0.020</u>
Screen Type	Depth to Bottom - Feet	
<b>ROD BASE</b>	<u>256</u>	

GEOLOGIC DATA (Office Use Only)			
Surface Elev.	Geologic Unit	Unit Thickness	Depth to Top
Subs. SWL	Date	Analysis	Aquifer Test
Driller's Remarks <b>2 FT. STICK UP ABOVE</b>			
GROUND LEVEL			

DESCRIPTION OF FORMATIONS ENCOUNTERED	FROM	TO
SAND AND GRAVEL	0	120
CLAY	120	174
SAND	174	290
CLAY	290	300

FORMATIONS (Continued)	FROM	TO
 <b>JUL 07 1999</b>		
		
IF MORE SPACE IS NEEDED, USE BACK		

