

MISSISSIPPI DEPARTMENT OF NATURAL RESOURCES

Bureau of Land and Water Resources

Southport Mall

P.O. Box 10631

Jackson, Mississippi 39209

CODED

WATER WELL DRILLERS LOG

Griner Drilling Service, Inc.

Pike

PIKE  
A 207  
6/4/83

6-4-83 date well completed

Griner Drilling Service, Inc. firm name

Pike county well located

LANDOWNER:	description of formations encountered	from	to
See Land Drilling P.O. Box 311 Magnolia, Ms. 39652 (mailing address)	SAND-pea gravel	D-189	
<b>WELL LOCATION:</b> 1650'N + 2352'W			
sec 20 T 4N R 7E S 10W			
No. 1 Albea olive field Dr. Colton (direction) of (nearest town)			
<b>WELL PURPOSE:</b> oil field supply (home, irrigation, municipal, industrial)			
<b>WELL COMPLETION DATA:</b>			
CODED			
(1) diameter (inches) 3"			
(2) total depth (feet) 185'			
(3) static water level (feet) 30' below top of ground.			
(4) casing steel 189'			
(material) (depth)			
3" if telescope see back.			
(5) screen 42' 147'			
(length) (depth to top)			
3" perforated			
(size) (material)			
(6) pump - 75			
(HP) (yield gpm)			
AC			
(type power)			
(7) electric log (yes or no)			
(organization running log)			
(8) how well bottom plugged ORANGE			
pee			

DEPT. OF NATURAL RESOURCES  
BUREAU OF LAND & WATER RESOURCES


JUN 22 1983

RECEIVED

DRILLERS REMARKS:

If well telescopes please sketch and show depths.

GROUND LEVEL

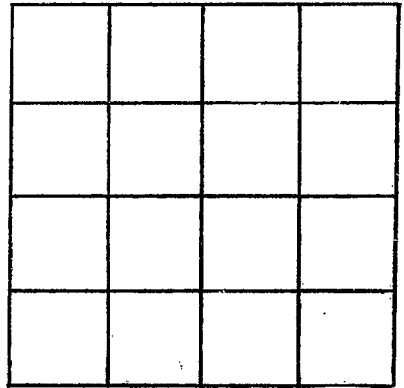

SECTION \_\_\_\_\_

Please indicate well location X.

ADDITIONAL INFORMATION

If more than one screen, show locations of each on sketch.