~	State Wo	ell Report			
Sounty: Pike	Part 1 – <b>Driller's Log</b>		For Office Use Only:		
Permit #:	Mississippi Department of Environmental Quality Office of Land and Water Resources		Aquifer: A 252		
Driller: 0 - 8 0 8	P.O. Box 2309		Well #:		
		MS 39225 61- 5210	L. S. Elevation:		
Date drilling completed: 417- 7011	,	- 5228 (fax)	E-log #:		
State Law requires that this repor	ı t be prepared by the licer	nse holder responsible for t			
Department at the above address	within 30 days of compl	etion of drilling of the well	or borehole.		
Information on Well ( (Landowner if borehole is not fo	or a water well		rehole Location		
Owner Name Southwest Miss.	THE RESERVE THE PROPERTY OF TH	Latitude: 31 ° 17 , 45	" Longitude: 90 <u>• 76</u> , <u>50</u> "		
Mailing Address: 1156 College		Method of Lat/Long (circle or	ne): Conventional Survey,		
J	<u> </u>		GPS, Survey-grade GPS		
Summit ms	3 966 6	92 1/4 58 1/4 Sec 24	Twn 4N Rng 7E		
Summit ms City Sta		Distance Direction NE	Nearest Town		
Telephone No. (601) 776-700	0	Miles_IVC	OI_JMMM; +		
	Well / Boreh	ole Data			
Date drilling started: 4-11-2011 Date dr	illing completed: 4-17-2	Hole depth: 7∞'	Hole diameter: 77/8"		
Location of the source of any surface water	er used for drilling:	16			
Method of dosing and volume of Chloring	e used in drilling and develo	pment: <u>Clarinated</u>	public supply		
Logs run (circle all applicable): No log run Electric Gamma Ray Density Sonic Neutron Other:  Name of organization running log(s):					
Purpose of borehole (check one): Water W	ell _ Geotechnical/Geolog	gical Investigation Ground	Source Heat Pump		
	Survey Other (describe)		5.5		
If drilling is not related	to water well construction	, skip the remainder of this blo	ock		
Purpose of Well (check one): Home I	ndustrial Public Supply_	Irrigation Fish Culture	Other:		
If a flowing well, method of flow regulation: Valve Other (describe)					
Static Water Level: 55.8 feet above or below (circle one) land surface Date measured: 4-17- 7011					
Method of Measurement (circle one) steel tape electric tape air line other:					
Well depth: / 9 7' Well grouted to a depth of /70' feet Type of grout (circle one) Neat Cement Bentonite Mix					
Casing length: 177' feet Casing diameter: 4" inches Type of casing: 5ch 40 PVC					
Screen length: 70 feet Screen diameter: 4" inches Type of screen: sch 40 PVC slot					
Screen slot size:					
Type of completion (circle all applicable): Gravel packed Underreamed Telescoped Open hole Natural Development					
Other (describe):					
Top of lap pipe or reduction in casing:	feet. <i>If tele</i>	scoped or more than one scre	en, describe on next page		

Form: OLWR-SWR-14 (04/08)


If well	telescopes,	show	depths	on	sketch.

Ground Level

Description of formations encountered must be provided for all wells and boreholes, unless specifically exempted by regulations

Description of Formations Encountered	From (depth)	To (depth)
Red day	Ground Level	25'
Sand w/ Dec grave!	751	lix'
Sond w/clay streats	110	165'
course sond	165'	1971
blue day	197	Z30 \

If more than one screen, show location of each on sketch

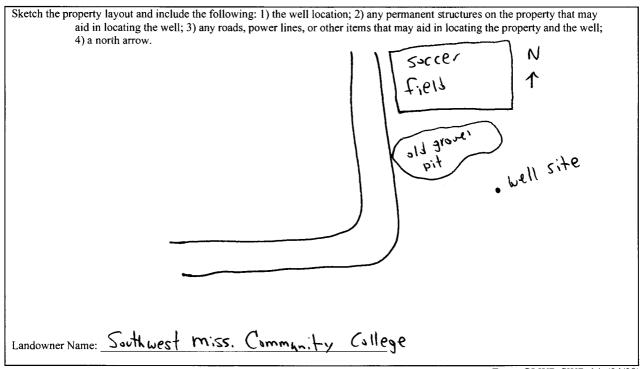

Form: OLWR-SWR-1A (04/08)

1 certify that the well/borehole was drilled, constructed, and completed in accordance with all applicable requirements of the Mississippi Department of Environmental Quality and the Mississippi Department of Health regulations, if applicable, and state

4-12-2011

Print Name of Responsible Licensee and License No.

Date

Signature of Licensee

## STATE WELL REPORT

## County: Pike Permit #: Driller: 0-806 Date completed: 4-17-201) Copy information from block on Part 1

## Part 2

## Pump Installer's Completion Report Mississippi Department of Environmental Quality Office of Land and Water Resources

P.O. Box 2309 Jackson, MS 39225 (601)961-5210 (601)961-5228 (fax)

For Office Use Only:				
Aquifer:				
Well #:				
Elevation:				

This part of the report must be completed by a licensed water well contractor or a licensed pump installer. A copy of Part 1 of the report must be attached and both parts filed with the Department at the above address within 30 days of well completion.					
Well Owner Information				Well Location	
Owner Name: Southwest niss. Community College			Latitude: 31°17	43 Longitude:	90° 76′ 50
Mailing Address: 1156 Callege Drive			(check one): Convention		
			USGS quad, F	Hand-held GPS <u>/</u> , Sur	vey-grade GPS
Shumit Ms. 39666 City State Zip Code		1/41/4	SecT	_ R	
			Distance Di	irection Nearest	Town
Telephone No. (631) 776- Z300				IE of Show	<i>+</i> ;.
Pump Type Circle one		Power Type Circle one			
Air Lift	Jet	Submersible	Diesel Engine	Gasoline Engine	Natural Gas
Bucket	Piston	Turbine	Électric Motor	Hand	Tractor PTO
Centrifugal	Rotary	Flowing Well	Windmill	Other (specify):	
Other (specify):		<u> </u>	Horse Power Rating	g of Motor: 1/2 k	P
Date Pump Installed: 4-17-201)		Setting Depth:	85,	feet	
Rated Pump Capacit	ty:10	Gallons Per Minute	Number of Stages:	8	
	Pump Test Da	ita		nod of Measuring Wate	er Level
(12 22)		Circle one			

Pump Test Data	vietnod of Measuring water Level		
Date Well Tested: 4-17 - 2011	Circle one		
Static Water Level (A): 55. 8 Feet Below Land Surface  Pumping Water Level (B): 58.8 Feet Below Land Surface	Air Line Electric Measuring Line Steel Tape  Other (specify):		
Drawdown [(B) – (A)]:Feet Below Land Surface	For flowing well, measured shut in head:feet		
Test Pumping Rate:	Well yieldedGPM with a drawdown of		
Duration of Pump Test (minimum 4 hours): hours	feet after 4 hours of pumping		

I HEREBY CERTIFY t	that the above sta	ntements are true to the b	est of my knowledge	0	
Clinton I	Juna	303-0	Clinton	Junn	
Print Name of Pump Ins	staller and Licen	se No. (if applicable)	Signature o	of Pump Installer	DECEME
				Form: O	LWR-SWR-1B (04/08)