

Pike  
 A 2000  
 10-14-75

MISSISSIPPI  
 BOARD OF WATER COMMISSIONERS  
 416 North State Street  
 Jackson, Mississippi 39201

WATER WELL DRILLERS LOG

Oct 14 1975 *Reynolds Well Service* *Pike*  
 date well completed firm name county well located

LANDOWNER:  
*Clyde Brown*  
*Rt. Summit*  
 (mailing address)

description of formations encountered	from	to
<i>Red clay</i>	<i>0</i>	<i>10</i>
<i>Red sand</i>	<i>10</i>	<i>40</i>
<i>Sand &amp; chert</i>	<i>40</i>	<i>70</i>
<i>Sand &amp; pea gravel</i>	<i>70</i>	<i>110</i>

WELL LOCATION:  
 sec. *8* T *4* N R *7* E  
*4* miles *N-NW* of *Summit*  
 (distance) (direction) (nearest town)

WELL PURPOSE: *Domestic*  
 (home, irrigation, municipal, industrial)


- WELL COMPLETION DATA:
- (1) diameter (inches) *4"*
  - (2) total depth (feet) *110*
  - (3) static water level (feet) *59* below above top of ground.
  - (4) casing *plastic, cotton* (material) (depth)
  - 2* (size) If telescope see back.
  - (5) screen *6'* *104* (length) (depth to top)
  - 4"* *plastic* (size) (material)
  - (6) pump *1/2 Sub* *10* (HP) (yield gpm)
  - elect* (type power)
  - (7) electric log *no* (yes or no)
  - Wooden Plug* (organization running log)
  - (8) how well bottom plugged *Wooden Plug*

DRILLERS REMARKS:  
*Wooden Plug*

JAN 12 1976  
 MISSISSIPPI BOARD OF WATER COMMISSIONERS

If well telescopes please sketch and show depths.

GROUND LEVEL

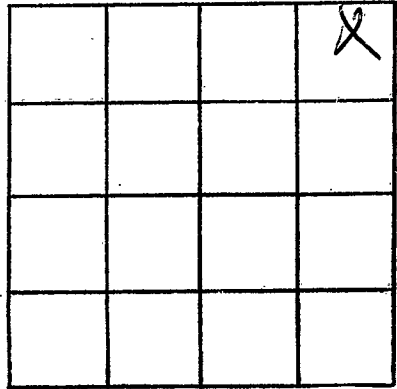

SECTION 8

Please indicate well location X.

ADDITIONAL INFORMATION

If more than one screen, show locations of each on sketch.