

Pike
 A 2001
 10-30-75

MISSISSIPPI
 BOARD OF WATER COMMISSIONERS
 416 North State Street
 Jackson, Mississippi 39201

WATER WELL DRILLERS LOG

30 Oct 1975 J.T. Conington Pike
 date well completed firm name county well located

LANDOWNER:
 A. R. Caruth
 Summit
 (mailing address)


description of formations encountered	from	to
clay	0	25
chalky sand & gravel	25	60
sand	60	102

WELL LOCATION:
 sec. 11 T 4 N R 7 E
 S W
 5 miles N of Summit
 (distance) (direction) (nearest town)

WELL PURPOSE:
 (home, irrigation, municipal, industrial)


- WELL COMPLETION DATA:
- (1) diameter (inches) 4
 - (2) total depth (feet) 102
 - (3) static water level (feet) 25 below above top of ground.
 - (4) casing 4 (material) 96 (depth)
 (size) if telescope see back.
 - (5) screen 6 (length) 96 (depth to top)
4 (size) 4 (material)
 - (6) pump 1/2 (HP) 10 (yield/gpm)
 (type power)
 - (7) electric log (yes or no)
 - (organization running log)
 - (8) how well bottom plugged

DRILLERS REMARKS:

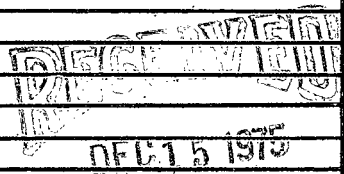

If well telescopes please sketch and show depths.

GROUND LEVEL

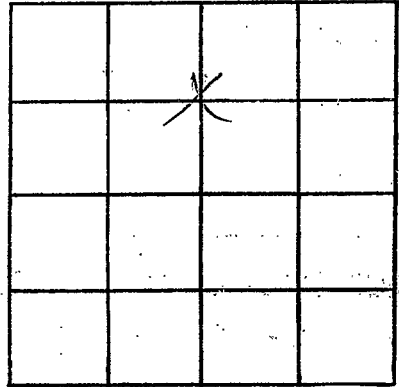

SECTION 11

Please indicate well location X.

ADDITIONAL INFORMATION

If more than one screen, show locations of each on sketch.