

Pike
A 2002
10-31-75

MISSISSIPPI
 BOARD OF WATER COMMISSIONERS
 416 North State Street
 Jackson, Mississippi 39201

WATER WELL DRILLERS LOG

Oct. 31 19 75 Grenn Water Well Contr. Pike
 date well completed firm name county well located

LANDOWNER: Gaylon Brown
Route 4
Summit, Miss.
 (mailing address)

description of fomations encountered	from	to
Citronelle	0	136

WELL LOCATION:
 sec. 3 4 N R. 7 E 134
9 miles N of McComb
 (distance) (direction) (nearest town)

WELL PURPOSE: home
 (home, irrigation, municipal, industrial)

- WELL COMPLETION DATA:
- (1) diameter (inches) 6
 - (2) total depth (feet) 136
 - (3) static water level (feet) 70 below top of ground.
 - (4) casing PVC, 130
 (material) (depth)
4"
 (size) If telescope see back.
 - (5) screen 6', 130'
 (length) (depth to top)
.010, PVC
 (size) (material)
 - (6) pump did not install
 (HP) (yield gpm)
 - (type power)
 - (7) electric log no
 (yes or no)
 - (organization running log)
 - (8) how well bottom plugged wood


DRILLERS REMARKS:

NOV 7 1975

MISSISSIPPI BOARD OF WATER COMMISSIONERS

If well telescopes please sketch and show depths.

GROUND LEVEL

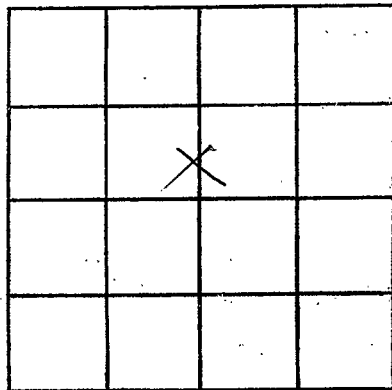

SECTION 3

Please indicate well location X.

ADDITIONAL INFORMATION

If more than one screen, show locations of each on sketch.