

Pike
A 2004
5/24/76

MISSISSIPPI
 BOARD OF WATER COMMISSIONERS
 416 North State Street
 Jackson, Mississippi 39201

WATER WELL DRILLERS LOG

5-24 ^{14H} 1976 Fitzgerald Well Co Pike
 date well completed firm name county well located

LANDOWNER:
Sherril Albritton
R.R. Summit Miss.
 (mailing address)

description of formations encountered	from	to
<u>Red Clay</u>	<u>0</u>	<u>20</u>
<u>Red Sand</u>	<u>20</u>	<u>95</u>
<u>Coarse Sand & gravel</u>	<u>95</u>	<u>108</u>

WELL LOCATION:
 sec. 5 T 4 N R 7 E
6 miles WNW of Summit
 (distance) (direction) (nearest town)

WELL PURPOSE: Home
 (home, irrigation, municipal, industrial)


- WELL COMPLETION DATA:
- (1) diameter (inches) 4
 - (2) total depth (feet) 108
 - (3) static water level (feet) 70 below above top of ground.
 - (4) casing PVC 100
 (material) (depth)
4 if telescope see back.
 (size)
 - (5) screen 8 100
 (length) (depth to top)
4 PVC
 (size) (material)
 - (6) pump 1/2 10
 (HP) (yield gpm)
Electric
 (type power)
 - (7) electric log no
 (yes or no)
 (organization running log)
 - (8) how well bottom plugged Sealed

DRILLERS REMARKS:

JUL 1 1976
 MISSISSIPPI BOARD OF WATER COMMISSIONERS
 JACKSON, MISSISSIPPI

If well telescopes please sketch and show depths.

GROUND LEVEL

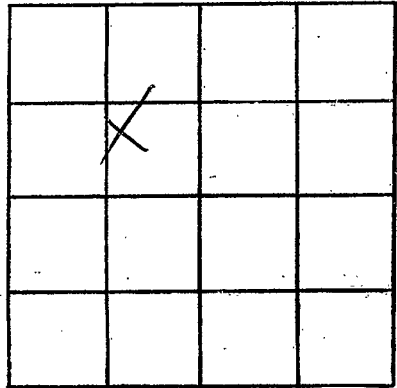

SECTION 5

Please indicate well location X.

ADDITIONAL INFORMATION

If more than one screen, show locations of each on sketch.