

Pike
A 2005
6-1-76

MISSISSIPPI
 BOARD OF WATER COMMISSIONERS
 416 North State Street
 Jackson, Mississippi 39201

134

WATER WELL DRILLERS LOG

June 1 1976 Beuss Well Co Pike
 date well completed firm name county well located

LANDOWNER:
Wesley Richardson
R. F. D. Summit
 (mailing address)

description of formations encountered	from to	
	feet	feet
<u>Clay</u>	<u>0</u>	<u>18</u>
<u>Red Sand</u>	<u>18</u>	<u>30</u>
<u>Pink Chalk</u>	<u>30</u>	<u>52</u>
<u>Yellow Sand</u>	<u>52</u>	<u>80</u>
<u>Sand & gravel</u>	<u>80</u>	<u>102</u>

WELL LOCATION:
 sec. 4 T. 4 N. R. 7 E
3 1/2 miles N-NE of Summit
 (distance) (direction) (nearest town)

WELL PURPOSE: home
 (home, irrigation, municipal, industrial)

WELL COMPLETION DATA:

(1) diameter (inches) 4"

(2) total depth (feet) 102

(3) static water level (feet) 65 below above top of ground.

(4) casing plastic bottom
 (material) (depth)
 (size) if telescope see back.

(5) screen 6' 96'
 (length) (depth to top)
4" plastic
 (size) (material)

(6) pump 1/2 HP 100
 (HP) (yield gpm)
1/2 HP
 (type power)

(7) electric log no
 (yes or no)
 (organization running log)

(8) how well bottom plugged
wooden plug

DRILLERS REMARKS:
old 2" well reset


RECEIVED

AUG 20 1976

MISS. BD. OF WATER COMM

If well telescopes please sketch and show depths.

GROUND LEVEL

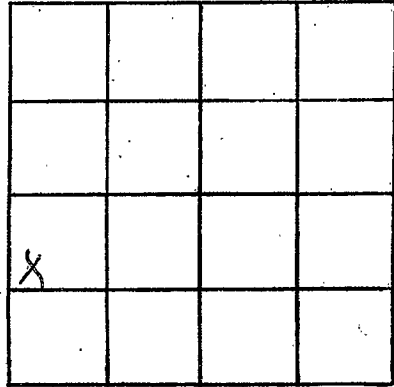

SECTION 4

Please indicate well location X.

ADDITIONAL INFORMATION

If more than one screen, show locations of each on sketch.