

Pike
A 2000
8/26/76

MISSISSIPPI
 BOARD OF WATER COMMISSIONERS
 416 North State Street
 1321 Jackson, Mississippi 39201

WATER WELL DRILLERS LOG

26 Aug 1976 J. T. Grayston Pike
 date well completed firm name county well located

LANDOWNER:

John Daniel Fowler

Summit
 (mailing address)

WELL LOCATION: RT

sec. 15 T 84 N R 2 E

4 miles W of Summit
 (distance) (direction) (nearest town)

WELL PURPOSE:

(home, irrigation, municipal, industrial)

WELL COMPLETION DATA:

- (1) diameter (inches) 4
- (2) total depth (feet) 115
- (3) static water level (feet) 25 below top of ground
- (4) casing PI 109
 (material) (depth)
 (size) if telescope see back.
- (5) screen 6 109
 (length) (depth to top)
4 PI
 (size) (material)
- (6) pump 1/2 8
 (HP) (yield gpm)
glut
 (type power)
- (7) electric log _____
 (yes or no)


 (organization running log)
- (8) how well bottom plugged wood

description of formations encountered

from to

<u>Chert</u>	<u>0</u>	<u>20</u>
<u>clay sand</u>	<u>20</u>	<u>45</u>
<u>gravel</u>	<u>45</u>	<u>60</u>
<u>shales</u>	<u>60</u>	<u>70</u>
<u>sand</u>	<u>70</u>	<u>115</u>

DRILLERS REMARKS:

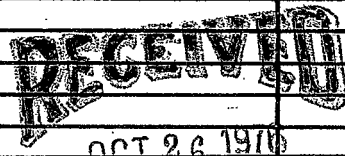

If well telescopes please sketch and show depths.

GROUND LEVEL

X			

SECTION 15

Please indicate well location X.

ADDITIONAL INFORMATION

If more than one screen, show locations of each on sketch.