

Pike
A 2007
9-2-76

MISSISSIPPI
 BOARD OF WATER COMMISSIONERS
 416 North State Street
 Jackson, Mississippi 39201

WATER WELL DRILLERS LOG

9-2
 date well completed

138

1976 Fitzgerald Well Serv
 firm name

Pike
 county well located


LANDOWNER:	description of formations encountered	from	to
<u>Al's Fish Camp</u>			
<u>R.R. Summit Mills</u> (mailing address)	<u>Red Clay</u>	<u>0</u>	<u>20</u>
	<u>Red Sand</u>	<u>20</u>	<u>90</u>
	<u>Red gravel</u>	<u>90</u>	<u>120</u>
	<u>Coarse Sand</u>	<u>120</u>	<u>130</u>
WELL LOCATION:			
sec. <u>10</u> T <u>4</u> N R <u>7</u> E			
<u>2</u> miles <u>N</u> of <u>Summit</u> (distance) (direction) (nearest town)			
WELL PURPOSE: <u>Home</u> (home, irrigation, municipal, industrial)			
WELL COMPLETION DATA:			
(1) diameter (inches) <u>4</u>			
(2) total depth (feet) <u>130</u>			
(3) static water level (feet) <u>175</u> below top of ground.			
(4) casing <u>PVC</u> , <u>122</u> , (material) (depth)			
<u>4</u> (size) If telescope see back.			
(5) screen <u>8</u> , <u>122</u> (length) (depth to top)			
<u>4</u> , <u>PVC</u> (size) (material)			
(6) pump <u>3/4</u> , <u>12</u> (HP) (yield gpm)			
<u>Clear</u> (type power)			
(7) electric log <u>No</u> (yes or no)			
<u></u> (organization running log)			
(8) how well bottom plugged <u>Sand Stop</u>			
DRILLERS REMARKS:			

RECEIVED
 OCT 2 1976

MISS. BOARD OF WATER COMMISSIONERS

If well telescopes please sketch and show depths.

GROUND LEVEL

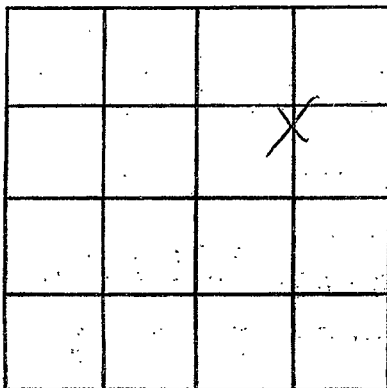

SECTION 10

Please indicate well location X.

ADDITIONAL INFORMATION

If more than one screen, show locations of each on sketch.