

Pike
A 2008
4/12/76

MISSISSIPPI
BOARD OF WATER COMMISSIONERS
416 North State Street
Jackson, Mississippi 39201

WATER WELL DRILLERS LOG

12 April
date well completed

76 Amosakwell Sec
firm name

Pike
county well located

LANDOWNER:
J. R. Causey
Summit
(mailing address)


description of formations encountered	from	to
<u>clay</u>	<u>0</u>	<u>25</u>
<u>red clay</u>	<u>25</u>	<u>45</u>
<u>chert</u>	<u>45</u>	<u>75</u>
<u>sand</u>	<u>75</u>	<u>92</u>

WELL LOCATION:
sec. 4 T. 4 N. R. 7 E.
2 miles N of Summit
(distance) (direction) (nearest town)

WELL PURPOSE:
(home, irrigation, municipal, industrial)


- WELL COMPLETION DATA:
- (1) diameter (inches) 4
 - (2) total depth (feet) 92
 - (3) static water level (feet) 75 below top of ground.
 - (4) casing pl (86 depth)
(material) (depth)
 - (size) If telescope see back.
 - (5) screen 6 (86 depth to top)
(length) (depth to top)
 - (size) 4 (material) pl
 - (6) pump 1/2 (8 yield gpm)
(HP) (yield gpm)
 - (type power)
 - (7) electric log (yes or no)
 - (organization running log)
 - (8) how well bottom plugged wood

DRILLERS REMARKS:

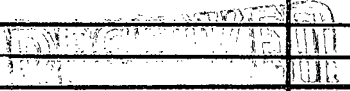
JUN 23 1976
MISSISSIPPI BOARD OF WATER COMMISSIONERS

If well telescopes please sketch and show depths.

GROUND LEVEL

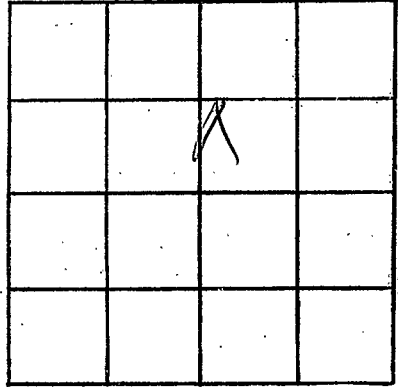

SECTION 14

Please indicate well location X.

ADDITIONAL INFORMATION

If more than one screen, show locations of each on sketch.