

Pike  
 A 2002  
 6/22/76

MISSISSIPPI  
 BOARD OF WATER COMMISSIONERS  
 416 North State Street  
 Jackson, Mississippi 39201

13U

WATER WELL DRILLERS LOG

June 22 1976 Picus Miller Pike  
 date well completed firm name county well located

LANDOWNER:  
Mrs. Charles Boulton  
Rt Summit  
 (mailing address)

description of formations encountered	from to	
<u>Red Clay</u>	<u>0</u>	<u>20</u>
<u>Red sand &amp; gravel</u>	<u>20</u>	<u>95</u>
<u>Sand &amp; gravel</u>	<u>95</u>	<u>111</u>

WELL LOCATION:  
 sec. 10 T. 4 N. R. 7 E  
3 miles north of Summit  
 (distance) (direction) (nearest town)

WELL PURPOSE: Trades  
 (home, irrigation, municipal, industrial)


- WELL COMPLETION DATA:
- (1) diameter (inches) 4 1/2"
  - (2) total depth (feet) 111'
  - (3) static water level (feet) 80 below above top of ground.
  - (4) casing plastic, bottom  
 (material) (depth)  
6" if telescope see back.  
 (size)
  - (5) screen 6" 105'  
 (length) (depth to top)  
4" plastic  
 (size) (material)
  - (6) pump 3/4 12  
 (HP) (yield gpm)  
float  
 (type power)
  - (7) electric log no  
 (yes or no)  
 (organization running log)

(8) how well bottom plugged  
wooden plug  
 DRILLERS REMARKS:  
new location

RECEIVED  
 OCT 22 1976

If well telescopes please sketch and show depths.

GROUND LEVEL

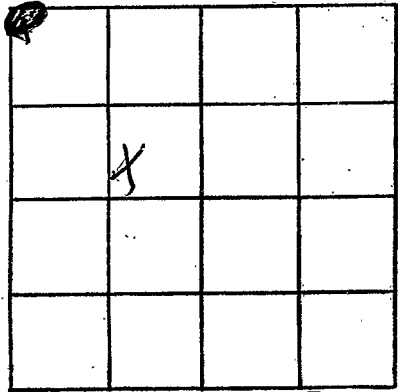

SECTION ~~3~~

Please indicate well location X.

ADDITIONAL INFORMATION

If more than one screen, show locations of each on sketch.