

Pike
 A 2010
 7/9/76

MISSISSIPPI
 BOARD OF WATER COMMISSIONERS
 416 North State Street
 Jackson, Mississippi 39201

WATER WELL DRILLERS LOG

July 9 1976 *Recess Well Sec* *Pike*
 date well completed firm name county well located

LANDOWNER:
Mrs Charles Boulton
H. Summit
 (mailing address)

description of formations encountered	from	to
<i>Red clay</i>	<i>0</i>	<i>20</i>
<i>Red sand chert</i>	<i>20</i>	<i>105</i>
<i>Gravel & sand</i>	<i>105</i>	<i>130</i>

WELL LOCATION:
 sec. *10* T. *4* N. R. *7* E
3 miles *north* of *Summit*
 (distance) (direction) (nearest town)

WELL PURPOSE: *residence*
 (home, irrigation, municipal, industrial)

WELL COMPLETION DATA:

(1) diameter (inches) *4"*

(2) total depth (feet) *130*

(3) static water level (feet) *70* below above top of ground.

(4) casing *plastic bottom*
 (material) (depth)

1 if telescope see back.
 (size)

(5) screen *6"* *124*
 (length) (depth to top)

4" *plastic*
 (size) (material)

(6) pump *by other's*
 (HP) (yield gpm)

elect
 (type power)

(7) electric log *NO*
 (yes or no)

NO
 (organization running log)

(8) how well bottom plugged:
Wooden plug


DRILLERS REMARKS:

RECEIVED
 OCT 22 1976

MISS. BD. OF WATER COMM

If well telescopes please sketch and show depths.

GROUND LEVEL

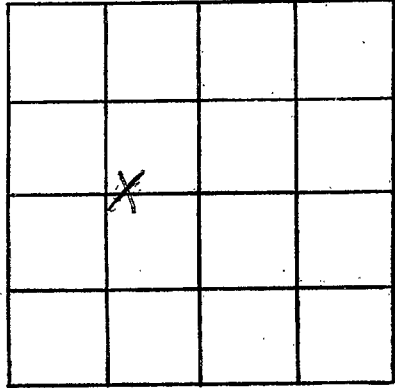

SECTION 10

Please indicate well location X.

ADDITIONAL INFORMATION

If more than one screen, show locations of each on sketch.