

PIKE
A 2012
9/26/77

MISSISSIPPI
BOARD OF WATER COMMISSIONERS
416 North State Street
Jackson, Mississippi 39201

131

WATER WELL DRILLERS LOG

9-26-77 1977 Reynolds Pike
date well completed firm name county well located

LANDOWNER:
Willie Ratliff
Old Summit
(mailing address)

description of formations encountered	from	to
<u>Red sandy clay</u>	<u>0</u>	<u>40</u>
<u>Red shaly</u>	<u>40</u>	<u>70</u>
<u>Sandy gravel</u>	<u>70</u>	<u>91</u>

WELL LOCATION:
sec. 10-T-4 N R-7 E
3 miles north of Summit
(distance) (direction) (nearest town)

WELL PURPOSE: home
(home, irrigation, municipal, industrial)

WELL COMPLETION DATA:
(1) diameter (inches) 4"
(2) total depth (feet) 91
(3) static water level (feet) 65 below top of ground.
(4) casing plastic bottom
(material) (depth)
 if telescope see back.
(size)
(5) screen 5' 86'
(length) (depth to top)
4" plastic
(size) (material)
(6) pump 2 hp 10
(HP) (yield gpm)
electric
(type power)
(7) electric log no
(yes or no)
no
(organization running log)


(8) how well bottom plugged
wooden plug
DRILLERS REMARKS:

RECEIVED
FEB 21 1978

MISS. BD. OF WATER COMM.

If well telescopes please sketch and show depths.

GROUND LEVEL

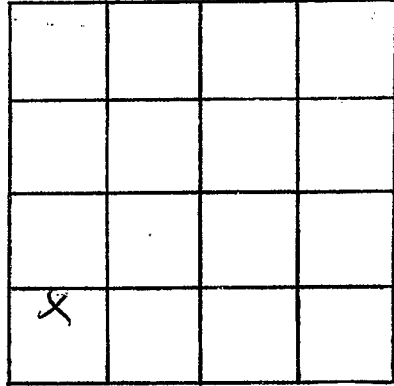

SECTION 10

Please indicate well location X.

ADDITIONAL INFORMATION

If more than one screen,
show locations of each on sketch.