

Pike
 A 2013
 7-18-77

MISSISSIPPI
 BOARD OF WATER COMMISSIONERS
 416 North State Street
 Jackson, Mississippi 39201

WATER WELL DRILLERS LOG

1322

7-18 1977 Fitzgerald file
 date well completed firm name county well located


LANDOWNER:	description of formations encountered	from	to
<u>Charlie Bolian</u>			
<u>P.O. Summit - Miss.</u> (mailing address)	<u>Red clay</u> <u>Red sand</u> <u>Coarse sand & gravel</u>	<u>0</u> <u>20</u> <u>90</u>	<u>20</u> <u>90</u> <u>106</u>
WELL LOCATION: sec. <u>3</u> T <u>4</u> N R <u>7</u> E S W			
<u>3</u> miles <u>N</u> of <u>Summit</u> (distance) (direction) (nearest town)			
WELL PURPOSE: <u>Home</u> (home, irrigation, municipal, industrial)			
WELL COMPLETION DATA:			
(1) diameter (inches) <u>4</u>			
(2) total depth (feet) <u>106</u>			
(3) static water level (feet) <u>85</u> below top of ground.			
(4) casing <u>PVC</u> , <u>98</u> , (material) (depth) <u>4</u> (size) if telescope see back.			
(5) screen <u>8</u> , <u>98</u> (length) (depth to top) <u>4</u> , <u>PVC</u> (size) (material)			
(6) pump <u>1/2</u> , <u>10</u> (HP) (yield gpm) <u>elec</u> (type power)			
(7) electric log <u>no</u> (yes or no) (organization running log)			
(8) how well bottom plugged <u>level floor</u>			
DRILLERS REMARKS:			

RECEIVED
 AUG 29 1977

MISS. BD. OF WATER COMMISSIONERS

If well telescopes please sketch and show depths.

GROUND LEVEL

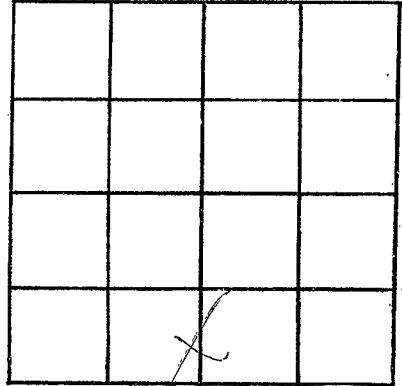

SECTION 3

Please indicate well location X.

ADDITIONAL INFORMATION

If more than one screen,
show locations of each on sketch.