

PIKE

A 2014


4-17-78

MISSISSIPPI BOARD OF WATER COMMISSIONERS 416 North State Street Jackson, Mississippi 39201

WATER WELL DRILLERS LOG

April 17 1978 Newsum Well Dr. Pike date well completed firm name county well located

LANDOWNER:	description of formations encountered	from	to
Bobby Ward Rt 1 Summit (mailing address)	Red Clay Red sand gravel	0 22 54	25 74 80
WELL LOCATION:			
sec. 15 T 4 N R 7 E			
1 1/2 miles N-NW of Summit (distance) (direction) (nearest town)			
WELL PURPOSE: house (home, irrigation, municipal, industrial)			
WELL COMPLETION DATA:			
(1) diameter (inches) 4"			
(2) total depth (feet) 80'			
(3) static water level (feet) 58' below top of ground.			
(4) casing plastic bottom (material) (depth)			
_____ if telescope see back. (size)			
(5) screen 5' 75' (length) (depth to top)			
4" plastic (size) (material)			
(6) pump 1/2 HP 10 (HP) (yield gpm)			
_____ (type power)			
(7) electric log no (yes or no)			
_____ (organization running log)			
(8) how well bottom plugged Wooden plug			
DRILLERS REMARKS: _____			

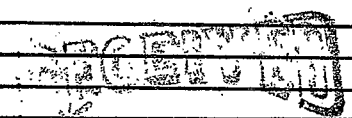


JUN - 8 1978

MISS. BD. OF WATER COMMISSIONERS

If well telescopes please
sketch and show depths.

GROUND LEVEL

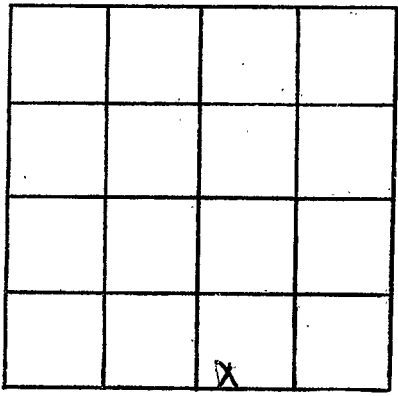

SECTION 15

Please indicate well location X.

ADDITIONAL INFORMATION

If more than one screen,
show locations of each on sketch.