

PIKE
 A 2015
 6-26-78

MISSISSIPPI
 BOARD OF WATER COMMISSIONERS
 416 North State Street
 Jackson, Mississippi 39201


WATER WELL DRILLERS LOG

6-26 1978 Fitzgerald Lumber Co Pike
 date well completed firm name county well located

LANDOWNER:	description of formations encountered	from	to
<u>Joe Lewis</u> <u>R.R. Summit, mo.</u> (mailing address)	<u>Red clay</u> <u>White chalk</u> <u>Coarse sand & gravel</u>	<u>0</u> <u>20</u> <u>80</u>	<u>20</u> <u>80</u> <u>94</u>
WELL LOCATION:			
sec. <u>11</u> T. <u>4N</u> S. R. <u>7E</u> W. <u>4</u> miles <u>N</u> of <u>Summit</u> (distance) (direction) (nearest town)			
WELL PURPOSE: <u>Home</u> (home, irrigation, municipal, industrial)			
WELL COMPLETION DATA:			
(1) diameter (inches) <u>4</u>			
(2) total depth (feet) <u>94</u>			
(3) static water level (feet) <u>40</u> below above top of ground.			
(4) casing <u>PVC</u> , <u>86</u> , (material) (depth) <u>4</u> (size) If telescope see back.			
(5) screen <u>8</u> , <u>86</u> (length) (depth to top)			
<u>4</u> , <u>PVC</u> (size) (material)			
(6) pump <u>3/4</u> , <u>15</u> (HP) (yield gpm)			
<u>elec</u> (type power)			
(7) electric log <u>no</u> (yes or no)			
(organization running log)			
(8) how well bottom plugged <u>level back</u>			
DRILLERS REMARKS:			

If well telescopes please sketch and show depths.

GROUND LEVEL

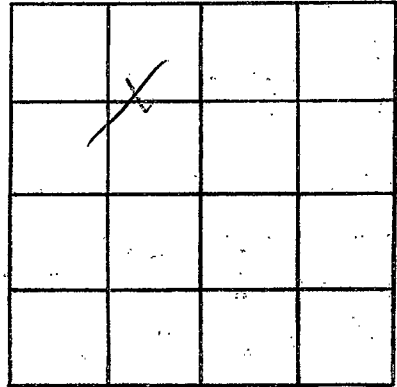

SECTION 21

Please indicate well location X.

ADDITIONAL INFORMATION

If more than one screen,
show locations of each on sketch.