

PIKE

A 206

8-18-78

MISSISSIPPI
 BOARD OF WATER COMMISSIONERS
 416 North State Street
 Jackson, Mississippi 39201

WATER WELL DRILLERS LOG

8-18

date well completed

19

78 Fitzgerald Well Co

firm name

Pike

county well located

LANDOWNER:

Dan McKenzie

R.B. Summit ms
(mailing address)

description of formations encountered

from

to

Red clay

0 20

Red sand

20 80

Coarse sand & gravel

80 100

WELL LOCATION:

sec. 10 T 4 N R 7 E
 S W
 4 miles N of Summit
 (distance) (direction) (nearest town)

WELL PURPOSE:

Home
(home, irrigation, municipal, industrial)

WELL COMPLETION DATA:

- (1) diameter (inches) 4
- (2) total depth (feet) 100
- (3) static water level (feet) 60 below top of ground.
- (4) casing PVC 92 (material) (depth)
4 (size) if telescope see back.
- (5) screen 8 92 (length) (depth to top)
4 (size) PVC (material)
- (6) pump 3/4 15 (HP) (yield gpm)
Electric (type power)
- (7) electric log (yes or no)
- (8) how well bottom plugged Seal block

DRILLERS REMARKS:


RECEIVED

OCT 3 1978

MISS. BD. OF WATER COMM

If well telescopes please sketch and show depths.

GROUND LEVEL

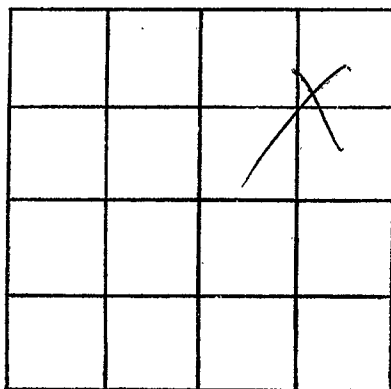

SECTION 10

Please indicate well location X.

ADDITIONAL INFORMATION

If more than one screen, show locations of each on sketch.