

PIKE
 A 2018
 9-15-78

MISSISSIPPI
 BOARD OF WATER COMMISSIONERS
 416 North State Street
 Jackson, Mississippi 39201

WATER WELL DRILLERS LOG

9-15-78 date well completed 19-78 *Fitzgibbon Well Dr.* firm name *Pike* county well located

LANDOWNER:	description of formations encountered	from	to
<i>James Ballard</i> <i>P.R. Summit</i> (mailing address)			

WELL LOCATION:
 sec. 25 T 4 N S R 7 E W
1/4 miles E of Summit
 (distance) (direction) (nearest town)

WELL PURPOSE: Home
 (home, irrigation, municipal, industrial)

WELL COMPLETION DATA:

(1) diameter (inches) 4

(2) total depth (feet) 111

(3) static water level (feet) 56 below above top of ground.

(4) casing PVC 108
 (material) (depth)
4 if telescope see back.
 (size)

(5) screen 8 108
 (length) (depth to top)
4 PVC
 (size) (material)

(6) pump 1/2 10
 (HP) (yield gpm).
6.5
 (type power)

(7) electric log no
 (yes or no)

(organization running log)


(8) how well bottom plugged sealed

DRILLERS REMARKS:

RECEIVED
 OCT 4 1978

If well telescopes please sketch and show depths.

GROUND LEVEL

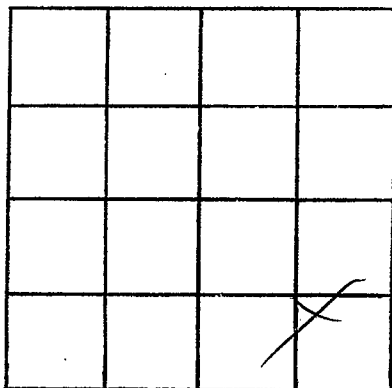

SECTION 25

Please indicate well location X.

ADDITIONAL INFORMATION

If more than one screen, show locations of each on sketch.