

PIKE
A 209
12-01-78

**MISSISSIPPI
BOARD OF WATER COMMISSIONERS**
416 North State Street
Jackson, Mississippi 39201

WATER WELL DRILLERS LOG

12-1 1978 *Fitzgerald Well Inc* *PIKE*
 date well completed firm name county well located


LANDOWNER:	description of formations encountered	from	to
<i>H.P. Couch</i>			
<i>R.R. Summit, Mo -</i> (mailing address)	<i>Red clay</i>	<i>0</i>	<i>20</i>
	<i>Red sand</i>	<i>20</i>	<i>95</i>
	<i>Coarse sand & gravel</i>	<i>95</i>	<i>114</i>
WELL LOCATION:			
sec. <i>12</i> T <i>4</i> N R <i>7</i> E S W			
<i>5</i> miles <i>NW</i> of <i>Summit</i> (distance) (direction) (nearest town)			
WELL PURPOSE: <i>Home</i> (home, irrigation, municipal, industrial)			
WELL COMPLETION DATA:			
(1) diameter (inches) <i>4</i>			
(2) total depth (feet) <i>114</i>			
(3) static water level (feet) <i>70</i> below top of ground.			
(4) casing <i>PVC</i> , <i>106</i> , (material) (depth)			
<i>4</i> if telescope see back. (size)			
(5) screen <i>8</i> , <i>106</i> (length) (depth to top)			
<i>4</i> , <i>PVC</i> (size) (material)			
(6) pump <i>1/2</i> <i>10</i> (HP) (yield gpm)			
<i>Ele</i> (type power)			
(7) electric log <i>no</i> (yes or no)			
(organization running log)			
(8) how well bottom plugged <i>Sand fill</i>			
DRILLERS REMARKS:			

RECEIVED
JAN 26 1978

MISS. BD. OF WATER COMMISSIONERS

If well telescopes please sketch and show depths.

GROUND LEVEL

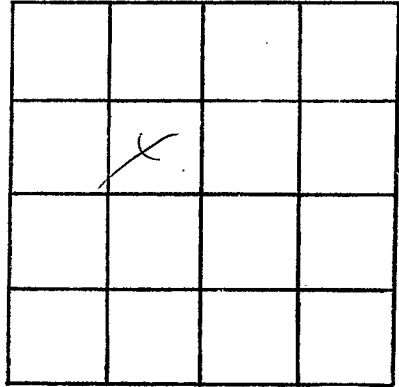

SECTION 12

Please indicate well location X.

ADDITIONAL INFORMATION

If more than one screen, show locations of each on sketch.