

PIKE
A 2021
1-16-79

**MISSISSIPPI
BOARD OF WATER COMMISSIONERS**
416 North State Street
Jackson, Mississippi 39201

WATER WELL DRILLERS LOG

1-16 19 79 *Fitzgibbon Inc* *Pike*
 date well completed firm name county well located

LANDOWNER:
Clyde Ratcheff
P.R. Summit, ms.
 (mailing address)

description of formations encountered	from	to
<i>Red clay</i>	<i>0</i>	<i>20</i>
<i>blue clay</i>	<i>20</i>	<i>70</i>
<i>Coarse sand & gravel</i>	<i>70</i>	<i>92</i>

WELL LOCATION:
 sec. *12* T-*4* N R-*2* E
 S W
3 miles *N* of *Summit*
 (distance) (direction) (nearest town)

WELL PURPOSE:
 (home, irrigation, municipal, industrial)

WELL COMPLETION DATA:

(1) diameter (inches) 4

(2) total depth (feet) 92

(3) static water level (feet) 45 below top of ground.

(4) casing PVC, 84,
 (material) (depth)
4 if telescope see back.
 (size)

(5) screen 8, 84
 (length) (depth to top)
4, PVC
 (size) (material)


(6) pump 3/4, 15
 (HP) (yield gpm)
Electric
 (type power)

(7) electric log no
 (yes or no)

(organization running log)

(8) how well bottom plugged Good plug

DRILLERS REMARKS:

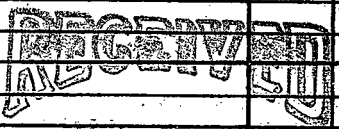

JAN 26 1978

