

MISSISSIPPI DEPARTMENT OF NATURAL RESOURCES

Bureau of Land and Water Resources

Southport Mall

P.O. Box 10631

Jackson, Mississippi 39209

WATER WELL DRILLERS LOG

<i>Pike</i>
<i>A 2022</i>
<i>11/4/80</i>
<i>Nov 4</i> 19 <i>80</i>
date well completed

*Reems Well Co* firm name *Pike* county well located

LANDOWNER:  
*Johnie Reems*  
*Summit*  
(mailing address)

description of formations encountered	from	to
<i>sandy clay</i>	<i>0</i>	<i>12</i>
<i>sand &amp; gravel</i>	<i>12</i>	<i>30</i>
<i>Red clay</i>	<i>30</i>	<i>53</i>
<i>gravel &amp; sand</i>	<i>53</i>	<i>68</i>
<i>Red sandy loam</i>	<i>68</i>	<i>136</i>
<i>limestone &amp; sand</i>	<i>136</i>	<i>150</i>

WELL LOCATION:  
sec. *15* T. *4* N. R. *7* E  
*1 1/2* miles (distance) *North* (direction) of *Summit* (nearest town)

WELL PURPOSE: *pond*  
(home, irrigation, municipal, industrial)

WELL COMPLETION DATA:

(1) diameter (inches) *4"*

(2) total depth (feet) *150*

(3) static water level (feet) *60* below top of ground

(4) casing *plaster bottom*  
(material) (depth)

*1* if telescope see back.  
(size)

(5) screen *10'* *140*  
(length) (depth to top)

*4"* *plastic*  
(size) (material)


(6) pump *key* *albas*  
(HP) (yield gpm)

*chat*  
(type power)

(7) electric log *no*  
(yes or no)

(organization running log)

(8) how well bottom plugged *back wash*

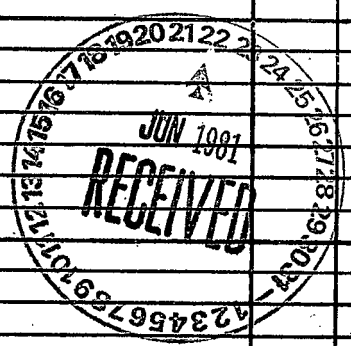

DRILLERS REMARKS:  
*[Signature]*

If well telescopes please sketch and show depths.

GROUND LEVEL

	X		

SECTION 15

Please indicate well location X.

ADDITIONAL INFORMATION

If more than one screen,  
show locations of each on sketch.

1  
2  
3  
4