

Pike
 A 2023
 6-19-81

MISSISSIPPI
 BOARD OF WATER COMMISSIONERS
 416 North State Street
 Jackson, Mississippi 39201


WATER WELL DRILLERS LOG

6-19
 date well completed

1981 *St. James Well Co.*
 firm name


Pike
 county well located

LANDOWNER:	description of formations encountered	from	to
<i>James Albritton</i> <i>R.R. Summit</i> (mailing address)	<i>Red clay</i> <i>Red sand</i> <i>Coarse sand & gravel</i>	0	20
WELL LOCATION:			
sec. <i>4</i> T <i>4</i> N R <i>2</i> E S <i>4</i> miles <i>NW</i> of <i>Summit</i> (distance) (direction) (nearest town)			
WELL PURPOSE: <i>Home</i> (home, irrigation, municipal, industrial)			
WELL COMPLETION DATA:			
(1) diameter (inches) <i>4</i>			
(2) total depth (feet) <i>150</i>			
(3) static water level (feet) <i>60</i> below top of ground.			
(4) casing <i>PVC</i> , <i>142</i> , (material) (depth)			
<i>4</i> (size) if telescope see back.			
(5) screen <i>8</i> , <i>142</i> (length) (depth to top)			
<i>4</i> , <i>PVC</i> (size) (material)			
(6) pump <i>1/2</i> , <i>10</i> (HP) (yield gpm)			
<i>Elec</i> (type power)			
(7) electric log <i>no</i> (yes or no)			
(organization running log)			
(8) how well bottom plugged <i>Small Shank</i>			
DRILLERS REMARKS:			

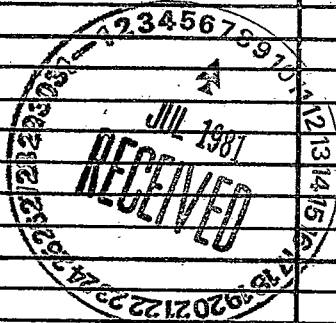

If well telescopes please sketch and show depths.

GROUND LEVEL

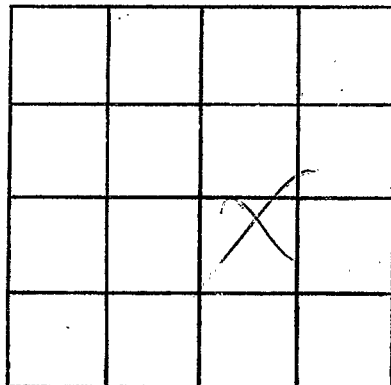

SECTION 27

Please indicate well location X.

ADDITIONAL INFORMATION

If more than one screen, show locations of each on sketch.