

Pike  
A 202e  
10-5-81

MISSISSIPPI  
BOARD OF WATER COMMISSIONERS  
416 North State Street  
Jackson, Mississippi 39201

WATER WELL DRILLERS LOG

10-5  
date well completed

1981 Fitzgerald Well Serv  
firm name

Pike  
county well located

LANDOWNER:	description of formations encountered	from	to
James Johnson	Red Clay	2	20
P.R. Semmitars. (mailing address)	Red Sand	20	70
	Coarse Sand & gravel	70	89
<b>WELL LOCATION:</b>			
sec. 9 T. 4 <sup>N</sup> R. 2 <sup>W</sup>			
4 miles NW of Summit (distance) (direction) (nearest town)			
<b>WELL PURPOSE:</b> (home, irrigation, municipal, industrial)			
<b>WELL COMPLETION DATA:</b>			
(1) diameter (inches) 4			
(2) total depth (feet) 89			
(3) static water level (feet) 55 below top of ground.			
(4) casing PVC, 81, (material), (depth), 4 (size) if telescope see back.			
(5) screen 8, 81 (length), (depth to top) 4, PVC (size), (material)			
(6) pump 1/2 HP, 10 (yield gpm) Ela (type power)			
(7) electric log (yes or no)			
(organization running log)			
(8) how well bottom plugged Sal M			

DEPT. OF NATURAL RESOURCES  
BUREAU OF LAND & WATER RESOURCES


NOV 20 1981

RECEIVED

DRILLERS REMARKS:

If well telescopes please sketch and show depths.

GROUND LEVEL

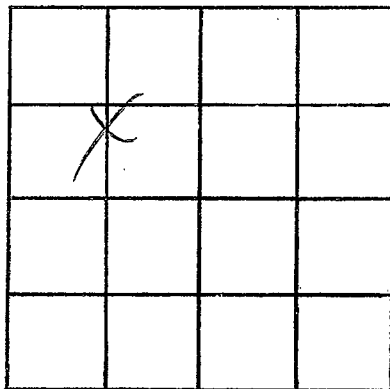

SECTION 9

Please indicate well location X.

ADDITIONAL INFORMATION

If more than one screen,  
show locations of each on sketch.