

MISSISSIPPI DEPARTMENT OF NATURAL RESOURCES

Bureau of Land and Water Resources

Southport Mall

P.O. Box 10631

Jackson, Mississippi 39209

WATER WELL DRILLERS LOG

Pike  
A 2028

Aug 26 1981  
date well completed

Purvis well ser  
firm name

Pike  
county well located

LANDOWNER:	description of formations encountered	from	to
<u>Rev. Ed Williams</u> <u>At Summit</u> (mailing address)	<u>red clay</u> <u>Red sand</u> <u>Gravel &amp; sand</u>	<u>0</u> <u>16</u> <u>62</u>	<u>16</u> <u>62</u> <u>83</u>
<b>WELL LOCATION:</b>			
sec <u>36</u> T <u>9</u> N R <u>7</u> E <u>1</u> miles <u>north</u> of <u>Mc Castle</u> (distance) (direction) (nearest town)			
<b>WELL PURPOSE:</b> <u>Beer Drink</u> (home, irrigation, municipal, industrial)			
<b>WELL COMPLETION DATA:</b>			
(1) diameter (inches) <u>4"</u>			
(2) total depth (feet) <u>83</u>			
(3) static water level (feet) <u>55</u> below above top of ground.			
(4) casing <u>plastic bottom</u> (material) (depth)			
_____ if telescope see back. (size)			
(5) screen <u>5'</u> <u>78'</u> (length) (depth to top)			
<u>4"</u> <u>plastic</u> (size) (material)			
(6) pump <u>1/2</u> <u>10</u> (HP) (yield gpm)			
<u>electric</u> (type power)			
(7) electric log <u>no</u> (yes or no)			
_____ (organization running log)			
(8) how well bottom plugged <u>best well value</u>			
<b>DRILLERS REMARKS:</b>			


DEPT. OF NATURAL RESOURCES  
BUREAU OF LAND & WATER RESOURCES

MAR 15 1982

RECEIVED

If well telescopes please sketch and show depths.

GROUND LEVEL

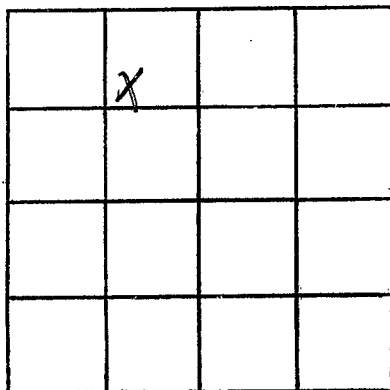

SECTION 36

Please indicate well location X.

ADDITIONAL INFORMATION

If more than one screen,  
show locations of each on sketch.