

MISSISSIPPI DEPARTMENT OF NATURAL RESOURCES

Bureau of Land and Water Resources

Southport Mall

P.O. Box 10631

Jackson, Mississippi 39209

WATER WELL DRILLERS LOG

Pike
A 2029

Griner Drilling Service, Inc.

Pike

date well completed

firm name

county well located

3-24-82

LANDOWNER:
Shell Oil Company
P.O. Box 61555
New Orleans, La. 70160
 (mailing address)

description of formations encountered	from	to
	<i>sand - pea gravel</i>	<i>0</i>
<i>clay</i>	<i>180</i>	<i>189</i>

WELL LOCATION: *683'S + 1994' W*
 sec. *19* T. *40* N. R. *7* E. *NE 1/4*
No. 2 Nelson Olive Field
 (distance) (direction) (nearest town)

WELL PURPOSE: *oil field supply*
 (home, irrigation, municipal, industrial)

- WELL COMPLETION DATA:
- (1) diameter (inches) *4"*
 - (2) total depth (feet) *189'*
 - (3) static water level (feet) *20'* ^{below} above top of ground.
 - (4) casing *steel* *189'*
 (material) (depth)
 - 4"* if telescope see back.
 (size)
 - (5) screen *42'* *147'*
 (length) (depth to top)
 - 4"* *perforated*
 (size) (material)
 - (6) pump — *75*
 (HP) (yield gpm)
 - AC*
 (type power)
 - (7) electric log —
 (yes or no)
 - (organization running log)

(8) how well bottom plugged *orange peel*

DRILLERS REMARKS:


DEPT. OF NATURAL RESOURCES
 BUREAU OF LAND & WATER RESOURCES

MAR 30 1982

RECEIVED

If well telescopes please sketch and show depths.

GROUND LEVEL

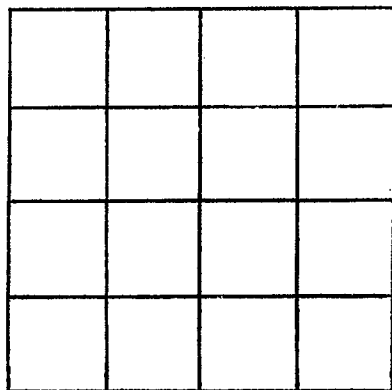

SECTION _____

Please indicate well location X.

ADDITIONAL INFORMATION

If more than one screen,
show locations of each on sketch.