

MISSISSIPPI DEPARTMENT OF NATURAL RESOURCES

Bureau of Land and Water Resources

Southport Mall

P.O. Box 10631

Jackson, Mississippi 39209

WATER WELL DRILLERS LOG.

Pike  
A 2030

4-14-82

Griner Drilling Service, Inc.

Pike

date well completed

firm name

county well located

LANDOWNER:	description of formations encountered	from	to
<u>Shell Oil Company</u> <u>P.O. Box 61555</u> <u>New Orleans, La. 70160</u> (mailing address)	<u>clay and sand</u> <u>sand, pea gravel</u> <u>sand and chalk</u>	<u>0</u> <u>21</u> <u>147</u>	<u>21</u> <u>147</u> <u>168</u>
WELL LOCATION: <u>2310'S + 990'W of</u> sec. <u>18</u> T <u>4</u> N R <u>7</u> E NE <u>1/4</u> <u>no. 1</u> miles <u>Olive Field</u> of (nearest town) <u>Griner</u> (distance) (direction)			
WELL PURPOSE: <u>oil field</u> (home, irrigation, municipal, industrial)			
WELL COMPLETION DATA:			
(1) diameter (inches) <u>4"</u>			
(2) total depth (feet) <u>168'</u>			
(3) static water level (feet) <u>30'</u> <sup>(below)</sup> <sub>(above)</sub> top of ground.			
(4) casing <u>steel</u> , <u>147'</u> (material) (depth)			
<u>4"</u> (size) If telescope see back.			
(5) screen <u>42'</u> , <u>105'</u> (length) (depth to top)			
<u>4"</u> <u>perforated</u> (size) (material)			
(6) pump <u>—</u> <u>80</u> (HP) (yield gpm)			
<u>ac</u> (type power)			
(7) electric log <u>—</u> (yes or no)			
<u>—</u> (organization running log)			
(8) how well bottom plugged <u>orange</u> <u>peel</u>			
DRILLERS REMARKS:			


DEPT. OF NATURAL RESOURCES  
BUREAU OF LAND & WATER RESOURCES

APR 21 1982

RECEIVED

If well telescopes please sketch and show depths.

GROUND LEVEL

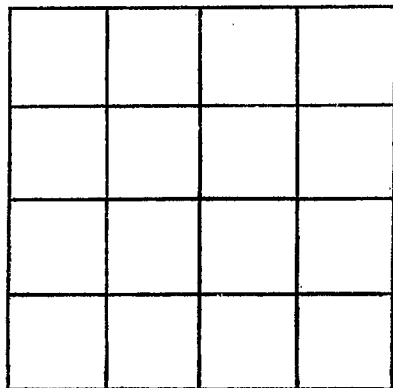

SECTION \_\_\_\_\_

Please indicate well location X.

ADDITIONAL INFORMATION

If more than one screen,  
show locations of each on sketch.