

MISSISSIPPI DEPARTMENT OF NATURAL RESOURCES

Bureau of Land and Water Resources

Southport Mall

P.O. Box 10631

Jackson, Mississippi 39209

WATER WELL DRILLERS LOG

Pike
A 2031

Griner Drilling Service, INC.

Pike

4-12-82 date well completed

Griner Drilling Service, INC. firm name

Pike county well located

LANDOWNER:	description of formations encountered	from	to
Shell Oil Company P.O. Box 61555 New Orleans, La 70160 (mailing address)	SAND pea gravel	0	168
WELL LOCATION: 1409'S + 2095'E sec. 18 T. 40N R. 70E NW/40N NO. 4 Olive Field (distance) (direction) (nearest town) WELL PURPOSE: oil field supply (home, irrigation, municipal, industrial)			
WELL COMPLETION DATA: (1) diameter (inches) 4" (2) total depth (feet) 168' (3) static water level (feet) 30' ^{below} / _{above} top of ground. (4) casing steel, 168' (material) (depth) 4" (size) if telescope see back. (5) screen 42' 126' (length) (depth to top) 4" perforated (size) (material) (6) pump AC (HP) 80 (yield gpm) (type power) (7) electric log (yes or no) (organization running log) (8) how well bottom plugged orange peel			
DRILLERS REMARKS:			


DEPT. OF NATURAL RESOURCES
BUREAU OF LAND & WATER RESOURCES

APR 13 1982

RECEIVED

If well telescopes please
sketch and show depths.

GROUND LEVEL

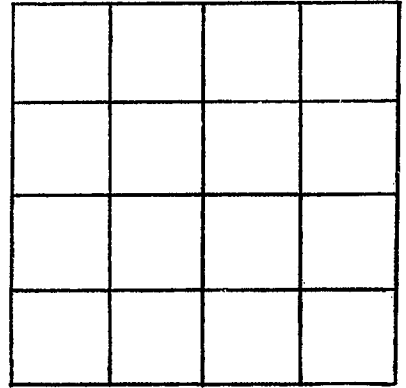

SECTION _____

Please indicate well location X.

ADDITIONAL INFORMATION

If more than one screen,
show locations of each on sketch.