

MISSISSIPPI DEPARTMENT OF NATURAL RESOURCES

Bureau of Land and Water Resources

Southport Mall

P.O. Box 10631

Jackson, Mississippi 39209

WATER WELL DRILLERS LOG

Griner Drilling Service, Inc.

Pike

<i>Pike</i>
<i>A</i>
<i>2032</i>

date well completed

firm name

county well located

LANDOWNER:

description of formations encountered

from

to

Shell Oil Company
P.O. Box 61555
New Orleans, La 70160
 (mailing address)

CHALK 0 21
SAND + DEA GRAVEL 21 147

WELL LOCATION: *1984' N + 1990' W*

sec. *18* T. *4* N. R. *7* E. *SE1/4*

CHALK 147 168

Olive Field

(distance) (direction) (nearest town)

WELL PURPOSE: *oilfield supply*
 (home, irrigation, municipal, industrial)

WELL COMPLETION DATA:

- (1) diameter (inches) *4"*
- (2) total depth (feet) *168'*
- (3) static water level (feet) *30'* below above top of ground.
- (4) casing *steel*, *168'*, *147'*
 (material) (depth)
4" if telescope see back.
 (size)
- (5) screen *42'*, *105'*
 (length) (depth to top)
4", *perforated*
 (size) (material)
- (6) pump *—* *80*
 (HP) (yield gpm)
AC
 (type power)
- (7) electric log *—*
 (yes or no)
—
 (organization running log)
- (8) how well bottom plugged *orange peel*

DEPT. OF NATURAL RESOURCES
 BUREAU OF LAND & WATER RESOURCES


MAY 14 1992

RECEIVED

DRILLERS REMARKS:

If well telescopes please sketch and show depths.

GROUND LEVEL

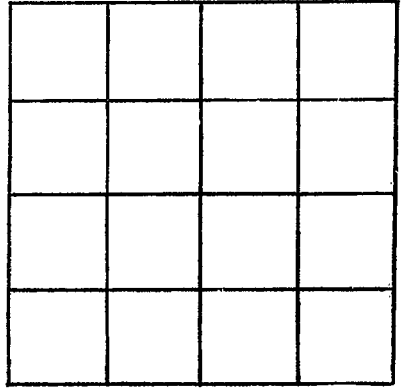

SECTION _____

Please indicate well location X.

ADDITIONAL INFORMATION

If more than one screen,
show locations of each on sketch.