

MISSISSIPPI DEPARTMENT OF NATURAL RESOURCES

Bureau of Land and Water Resources

Southport Mall

P.O. Box 10631

Jackson, Mississippi 39209

WATER WELL DRILLERS LOG

| |
|------|
| PIKE |
| A |
| 2033 |

Griner Drilling Service, Inc.

Pike

6-11-82 date well completed

Griner Drilling Service, Inc. firm name

Pike county well located

| | | | |
|---|--|-------------|-----------|
| <p>LANDOWNER: Shell Oil Company P.O. Box 61555 New Orleans, La 70160 (mailing address)</p> | <p>description of formations encountered</p> | <p>from</p> | <p>to</p> |
| | SAND pea gravel | 0 | 155 |
| | clay | 155 | 168 |
| <p>WELL LOCATION: 1701'S + 1986'E sec. <u>19</u> T. <u>4</u> R. <u>7</u> N. W. 1/4 No. 5 Olive Field (distance) (direction) (nearest town)</p> | | | |
| <p>WELL PURPOSE: oil field supply (home, irrigation, municipal, industrial)</p> | | | |

WELL COMPLETION DATA:

(1) diameter (inches) 4"

(2) total depth (feet) 168'

(3) static water level (feet) 40' ^{below} _{above} top of ground.

(4) casing steel 147'
 (material) (depth)
4"
 (size) If telescope see back.

(5) screen 42' 105'
 (length) (depth to top)
4" perforated
 (size) (material)

(6) pump — 100
 (HP) (yield gpm)
AC
 (type power)

(7) electric log —
 (yes or no)
 (organization running log)

(8) how well bottom plugged orange peel

DEPT. OF NATURAL RESOURCES
 BUREAU OF LAND & WATER RESOURCES


JUN 17 1982

RECEIVED

DRILLERS REMARKS:

If well telescopes please sketch and show depths.

GROUND LEVEL

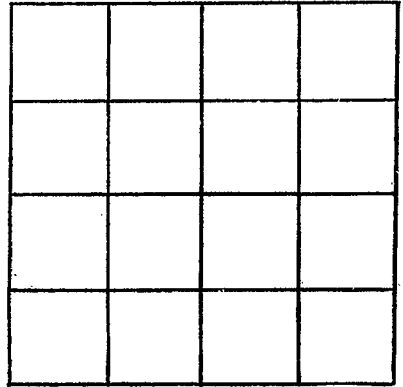

SECTION _____

Please indicate well location X.

ADDITIONAL INFORMATION

If more than one screen,
show locations of each on sketch.