

Pike  
A  
2035

MISSISSIPPI  
BOARD OF WATER COMMISSIONERS  
416 North State Street  
Jackson, Mississippi 39201

WATER WELL DRILLERS LOG

Sept. 13 1982 Bramfield Well Serv. Pike  
date well completed firm name county well located

LANDOWNER: Jimmy Williams  
Pt. Summit ms.  
(mailing address)

description of formations encountered	from	to
Surf Acc clay	0	16
SANDY CLAY	16	60
Fairly clean Sand	60	70
SAND & ROCK	70	85
Yea Gravel	85	100

WELL LOCATION:  
sec. 4 T. 4 N R. 7 E  
4 1/2 miles N.W. of Summit  
(distance) (direction) (nearest town)

WELL PURPOSE: home  
(home, irrigation, municipal, industrial)

- WELL COMPLETION DATA:
- (1) diameter (inches) 4"
  - (2) total depth (feet) 100'
  - (3) static water level (feet) 78' below above top of ground.
  - (4) casing Plastic 90'  
(material) (depth)  
4" if telescope see back.  
(size)
  - (5) screen 10' 90'  
(length) (depth to top)  
4" Plastic  
(size) (material)
  - (6) pump 1/2 sub 7  
(HP) (yield gpm)  
Electric  
(type power)
  - (7) electric log no  
(yes or no)

(organization running log)  
(8) how well bottom plugged Sand shark

DRILLERS REMARKS:


DEPT. OF NATURAL RESOURCES  
BUREAU OF LAND & WATER RESOURCES

SEP 29 1982

RECEIVED

If well telescopes please  
sketch and show depths.

GROUND LEVEL

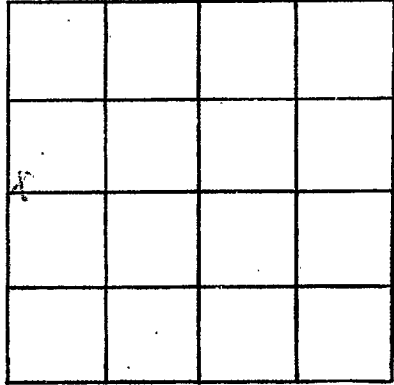

SECTION 4

Please indicate well location X.

ADDITIONAL INFORMATION

If more than one screen,  
show locations of each on sketch.