

PIKE
A 2036

MISSISSIPPI
 BOARD OF WATER COMMISSIONERS
 416 North State Street
 Jackson, Mississippi 39201

WATER WELL DRILLERS LOG

Sept. 14
 date well completed

82 Buntford Well Serv
 firm name

Pike
 county well located

LANDOWNER: Willie Wall
Pt. Summit Ms.

description of formations encountered	from	to
<u>SUMMER CLAY</u>	<u>0</u>	<u>22</u>
<u>CLAY & SAND</u>	<u>22</u>	<u>60</u>
<u>Red CLAY</u>	<u>60</u>	<u>74</u>
<u>SAND & CLAY</u>	<u>74</u>	<u>87</u>
<u>SAND & ROCKS</u>	<u>87</u>	<u>100</u>

(mailing address)

WELL LOCATION:

sec. 20 T 4 N R 7 E
2 1/2 miles W of Summit
 (distance) (direction) (nearest town)

WELL PURPOSE: Home
 (home, irrigation, municipal, industrial)

WELL COMPLETION DATA:

- diameter (inches) 4"
- total depth (feet) 100'
- static water level (feet) 72 below top of ground.
- casing Plastic 90'
 (material) (depth)
4" if telescope see back.
 (size)
- screen 10 90'
 (length) (depth to top)
1/2" Plastic
 (size) (material)
- pump 1/2 sub 10
 (HP) (yield gpm)
Electric
 (type power)
- electric log no
 (yes or no)

(organization running log)

(8) how well bottom plugged Sandstone

DEPT. OF NATURAL RESOURCES
 BUREAU OF LAND & WATER RESOURCES


DRILLERS REMARKS:

SEP 29 1982

RECEIVED

If well telescopes please sketch and show depths.

GROUND LEVEL

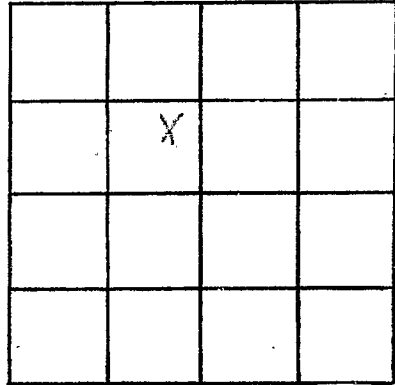

SECTION 20

Please indicate well location X.

ADDITIONAL INFORMATION

If more than one screen, show locations of each on sketch.