

MISSISSIPPI DEPARTMENT OF NATURAL RESOURCES

Bureau of Land and Water Resources

Southport Mall

P.O. Box 10631

Jackson, Mississippi 39209

WATER WELL DRILLERS LOG

Pike
A
2037
June 10 1982 Runus Miller Pike
 date well completed firm name county well located

LANDOWNER:

J. F. HarrisSummit

(mailing address)

WELL LOCATION:

sec. 14 T. 4 N. R. 7 E.

1 1/2 miles north of Summit
 (distance) (direction) (nearest town)

WELL PURPOSE:

(home, irrigation, municipal, industrial) Barn

WELL COMPLETION DATA:

- (1) diameter (inches) 4"
 (2) total depth (feet) 81
 (3) static water level (feet) 35' below above top of ground.

- (4) casing Plastic bottom
 (material) (depth)

5' If telescope see back.
 (size)

- (5) screen 5' 76'
 (length) (depth to top)

4" plastic
 (size) (material)

- (6) pump 1 sub 10
 (HP) (yield gpm)

elect
 (type power)

- (7) electric log no
 (yes or no)

(organization running log)

- (8) how well/bottom plugged back wash

DRILLERS REMARKS:

description of formations encountered

from

to

sandy clay	0	18
yellow sand	18	40
sand rock	40	41
sand & gravel	41	81


DEPT. OF NATURAL RESOURCES
 BUREAU OF LAND & WATER RESOURCES

NOV 22 1982

RECEIVED

If well telescopes please
sketch and show depths.

GROUND LEVEL

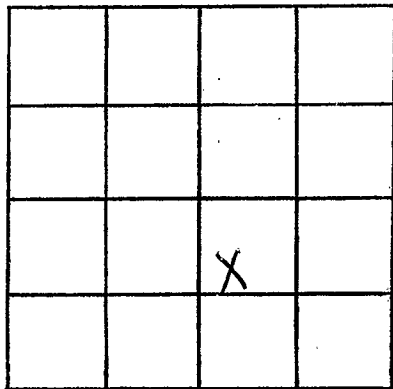

SECTION 14

Please indicate well location X.

ADDITIONAL INFORMATION

If more than one screen,
show locations of each on sketch.