

**PIKE**  
**A 2038**

MISSISSIPPI  
 BOARD OF WATER COMMISSIONERS  
 416 North State Street  
 Jackson, Mississippi 39201

WATER WELL DRILLERS LOG

10-6 1982 *Handwritten Signature* *Pike*  
 date well completed firm name county well located

LANDOWNER:	description of formations encountered	from	to
<i>Mike Smith</i>			
<i>R.R. Lemmit</i> (mailing address)	<i>Red Clay</i>	<i>0</i>	<i>20</i>
	<i>Red Sand</i>	<i>20</i>	<i>80</i>
	<i>Coarse Sand &amp; gravel</i>	<i>80</i>	<i>95</i>
<b>WELL LOCATION:</b>			
sec. <i>2</i> T <i>4</i> N R <i>7</i> E S W			
at <i>2</i> miles <i>Dixie Springs</i> of <i>Dixie Springs</i> (distance) (direction) (nearest town)			
<b>WELL PURPOSE:</b> <i>Home</i> (home, irrigation, municipal, industrial)			
<b>WELL COMPLETION DATA:</b>			
(1) diameter (inches) <i>4</i>			
(2) total depth (feet) <i>95</i>			
(3) static water level (feet) <i>30</i> below top of ground.			
(4) casing <i>PVC 87</i> , (material) (depth)			
<i>4</i> If telescope see back. (size)			
(5) screen <i>8 87</i> , (length) (depth to top)			
<i>4</i> , <i>PVC</i> (size) (material)			
(6) pump <i>1/2 10</i> (HP) (yield gpm)			
<i>5hp</i> (type power)			
(7) electric log <i>yes</i> (yes or no)			
(organization running log)			
(8) how well bottom plugged <i>Full</i>			
<b>DRILLERS REMARKS:</b>			


DEPT. OF NATURAL RESOURCES  
 BUREAU OF LAND & WATER RESOURCES

OCT 18 1987

RECEIVED

If well telescopes please sketch and show depths.

GROUND LEVEL

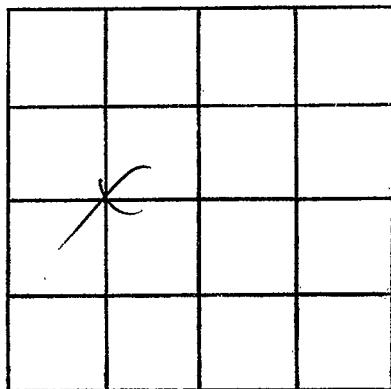

SECTION 2

Please indicate well location X.

ADDITIONAL INFORMATION

If more than one screen, show locations of each on sketch.