

MISSISSIPPI DEPARTMENT OF NATURAL RESOURCES

Bureau of Land and Water Resources

Southport Mall

P.O. Box 10631

Jackson, Mississippi 39209

WATER WELL DRILLERS LOG

Pike  
A  
2041

Hessell & Hill Inc Pike

2-14 1984 date well completed      firm name      county well located

LANDOWNER:  
Paul Holloway  
P.R. Smith, Sr.  
(mailing address)

description of formations encountered	from	to
<u>Red Clay</u>	<u>0</u>	<u>20</u>
<u>Red Sand</u>	<u>20</u>	<u>90</u>
<u>Coarse Sandstone</u>	<u>90</u>	<u>103</u>

WELL LOCATION:  
sec. 31 T 4 N R. 7 E  
S W  
0 miles W of Mark  
(distance) (direction) (nearest town)

WELL PURPOSE:  
(home, irrigation, municipal, industrial)

- WELL COMPLETION DATA:
- (1) diameter (inches) 4
  - (2) total depth (feet) 103
  - (3) static water level (feet) 60 below above top of ground.
  - (4) casing PVC, 95,  
(material) (depth)  
4 if telescope see back.  
(size)
  - (5) screen 8, 95  
(length) (depth to top)  
4, PVC  
(size) (material)
  - (6) pump 1/2, 10  
(HP) (yield gpm)  
Elm  
(type power)
  - (7) electric log no  
(yes or no)  
(organization running log)
  - (8) how well bottom plugged Sealed

DEPT. OF NATURAL RESOURCES  
BUREAU OF LAND & WATER RESOURCES


MAR -7 1984

RECEIVED

DRILLERS REMARKS:

If well telescopes please  
sketch and show depths.

GROUND LEVEL

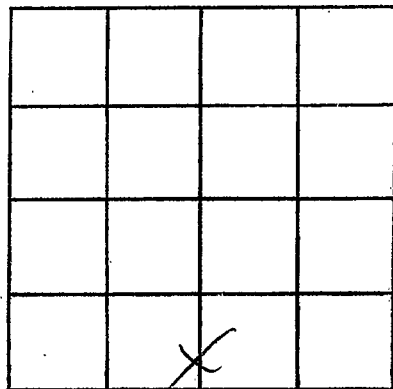

SECTION 31

Please indicate well location X.

ADDITIONAL INFORMATION

If more than one screen,  
show locations of each on sketch.