

MISSISSIPPI DEPARTMENT OF NATURAL RESOURCES

Bureau of Land and Water Resources

Southport Mall

P.O. Box 10631

Jackson, Mississippi 39209

WATER WELL DRILLERS LOG

Pike
A
2042

June 5 1984 Bevens Well Co Pike
 date well completed firm name county well located

LANDOWNER:
The Warehouse
(Amos Parker)
 (mailing address)

description of formations encountered	from	to
<u>Red sandy clay</u>	<u>0</u>	<u>15</u>
<u>white sand gravel</u>	<u>15</u>	<u>20</u>
<u>blue Chalk</u>	<u>20</u>	<u>93</u>
<u>sand & per gravel</u>	<u>93</u>	<u>120</u>

WELL LOCATION:
 sec. 12 T. 4 N R. 7 E
3 miles north of Summit
 (distance) (direction) (nearest town)

WELL PURPOSE: Large
 (home, irrigation, municipal, industrial)

WELL COMPLETION DATA:

(1) diameter (inches) 4"

(2) total depth (feet) 120

(3) static water level (feet) 50' below top of ground.

(4) casing plastic, bottom
 (material) (depth)

 if telescope see back.
 (size)

(5) screen 5', 115'
 (length) (depth to top)

4", plastic
 (size) (material)

(6) pump by others
 (HP) (yield gpm)

electric
 (type power)

(7) electric log no
 (yes or no)

 (organization running log)

(8) how well bottom plugged
back wash

DRILLERS REMARKS:


DEPT. OF NATURAL RESOURCES
 BUREAU OF LAND & WATER RESOURCES

JUN 11 1984

RECEIVED

If well telescopes please sketch and show depths.

GROUND LEVEL

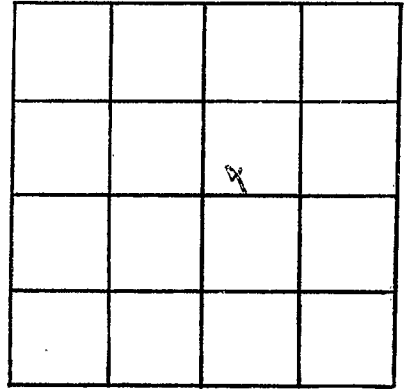

SECTION 12

Please indicate well location X.

ADDITIONAL INFORMATION

If more than one screen,
show locations of each on sketch.