

MISSISSIPPI DEPARTMENT OF NATURAL RESOURCES

Bureau of Land and Water Resources

Southport Mall

P.O. Box 10631

Jackson, Mississippi 39209

WATER WELL DRILLERS LOG

PIKE
A
2045

11-21 1985 Fitzgerald Sew Pike  
 date well completed firm name county well located

LANDOWNER:	description of formations encountered	from	to
<u>Ed Roberts</u> <u>R.R. Summit, ms.</u> (mailing address)			
WELL LOCATION:			
sec. <u>8</u> T <u>4</u> N R <u>7</u> E S W			
<u>4</u> miles <u>NW</u> of <u>Summit</u> (distance) (direction) (nearest town)			
WELL PURPOSE: <u>Home</u> (home, irrigation, municipal, industrial)			
WELL COMPLETION DATA:			
(1) diameter (inches) <u>4</u>			
(2) total depth (feet) <u>150</u>			
(3) static water level (feet) <u>80</u> below above top of ground.			
(4) casing <u>N/C</u> , <u>140</u> , (material) (depth) <u>4</u> if telescope see back. (size)			
(5) screen <u>10</u> , <u>140</u> (length) (depth to top) <u>4</u> , <u>N/C</u> (size) (material)			
(6) pump <u>1/2</u> <u>10</u> (HP) (yield gpm) <u>Elec</u> (type power)			
(7) electric log <u>no</u> (yes or no) <u>(organization running log)</u>			
(8) how well bottom plugged <u>✓</u>			


RECEIVED

NOV 27 1985

DRILLERS REMARKS:

If well telescopes please sketch and show depths.

GROUND LEVEL

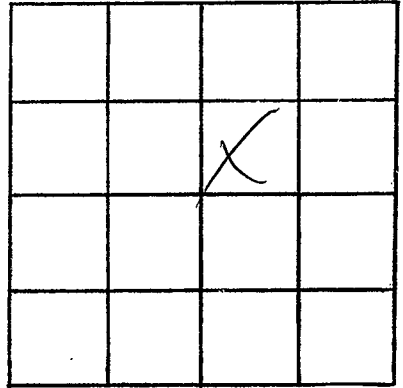

SECTION 8

Please indicate well location X.

ADDITIONAL INFORMATION

If more than one screen,  
show locations of each on sketch.