

MISSISSIPPI DEPARTMENT OF NATURAL RESOURCES

Bureau of Land and Water Resources

Southport Mall

P.O. Box 10631

Jackson, Mississippi 39209

WATER WELL DRILLERS LOG

PIKE  
A  
2046

3-19

19

86 Fitzgerald Well Serv

firm name

Pike

county well located

LANDOWNER:

Tommy Wallman

P.O. Box M<sup>c</sup>Comb, ms  
(mailing address)

WELL LOCATION:

sec. 35 T 4 N R 7 E  
S W  
1/4 miles N of M<sup>c</sup>Comb  
(distance) (direction) (nearest town)

WELL PURPOSE:

Home  
(home, irrigation, municipal, industrial)

WELL COMPLETION DATA:

- (1) diameter (inches) 4
- (2) total depth (feet) 190
- (3) static water level (feet) 45 below top of ground.
- (4) casing PVC, 180 (material) (depth)  
4 (size) if telescope see back.
- (5) screen 10, 180 (length) (depth to top)  
4 (size) PVC (material)
- (6) pump 1, 25 (HP) (yield gpm)  
Elec (type power)
- (7) electric log No (yes or no)  
(organization running log)
- (8) how well bottom plugged Sand plug

description of formations encountered

from

to

Red clay	0	20
Fine sand	20	80
Medium sand	80	90
White chalk	90	175
Coarse sand & gravel	175	190


DRILLERS REMARKS:

RECEIVED  
MAY 5 1986

Department of Natural Resources  
Bureau of Land & Water Resources

If well telescopes please sketch and show depths.

GROUND LEVEL

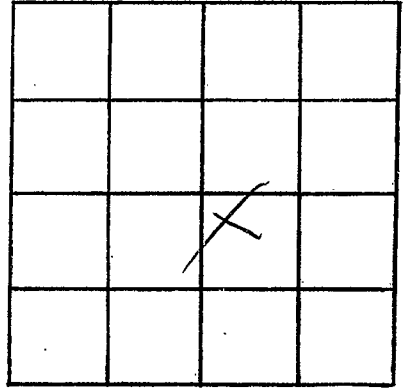

SECTION 25

Please indicate well location X.

ADDITIONAL INFORMATION

If more than one screen,  
show locations of each on sketch.