

MISSISSIPPI DEPARTMENT OF NATURAL RESOURCES

Bureau of Land and Water Resources

Southport Mall

P.O. Box 10631

Jackson, Mississippi 39209

WATER WELL DRILLERS LOG

PIKE
A 2047

12-27 1986
date well completed

Fitzgerald Well Serv
firm name

Pike
county well located

LANDOWNER:	description of formations encountered	from	to
<u>Elaine Bennett</u>			
<u>RR. Summit Mo.</u> (mailing address)	<u>Red clay</u>	<u>0</u>	<u>20</u>
	<u>Red gravel</u>	<u>20</u>	<u>42</u>
	<u>white chalk</u>	<u>42</u>	<u>147</u>
	<u>Coarse sand gravel</u>	<u>147</u>	<u>160</u>
WELL LOCATION:			
sec. <u>34</u> T <u>4</u> N R <u>2</u> E S W			
<u>1/4</u> miles <u>S</u> of <u>Summit</u> (distance) (direction) (nearest town)			
WELL PURPOSE:			
<u>Home</u> (home, irrigation, municipal, industrial)			
WELL COMPLETION DATA:			
(1) diameter (inches) <u>4</u>			
(2) total depth (feet) <u>160</u>			
(3) static water level (feet) <u>20</u> below top of ground. above			
(4) casing <u>100</u> <u>150</u> (material) (depth)			
<u>4</u> (size) if telescope see back.			
(5) screen <u>10</u> <u>150</u> (length) (depth to top)			
<u>4</u> <u>100</u> (size) (material)			
(6) pump <u>1/2</u> <u>10</u> (HP) (yield gpm)			
<u>Elu</u> (type power)			
(7) electric log <u>no</u> (yes or no)			
<u></u> (organization running log)			
(8) how well bottom plugged <u>Seal like</u>			
DRILLERS REMARKS:			


RECEIVED

FEB 12 1987

Department of Natural Resources
Bureau of Land & Water Resources

If well telescopes please sketch and show depths.

GROUND LEVEL

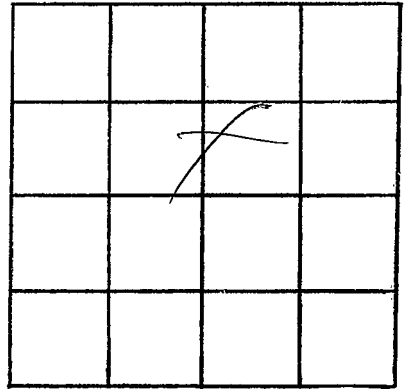

SECTION 34

Please indicate well location X.

ADDITIONAL INFORMATION

If more than one screen,
show locations of each on sketch.