

MISSISSIPPI DEPARTMENT OF NATURAL RESOURCES

Bureau of Land and Water Resources

Southport Mall

P.O. Box 10631

Jackson, Mississippi 39209

WATER WELL DRILLERS LOG

PIKE  
A 2048

March 26 1986 Grenn Water Well Lincoln PIKE  
date well completed firm name county well located


LANDOWNER: <u>Brian Mercier</u>	description of formations encountered	from	to
<u>Route 4</u>			
<u>Summit</u> (mailing address)			
<b>WELL LOCATION:</b>			
sec. <u>16</u> <u>4</u> N <u>4</u> R. <u>7</u> E S W			
<u>3</u> miles <u>NW</u> of <u>Summit</u> (distance) (direction) (nearest town)			
<b>WELL PURPOSE:</b> <u>home</u> (home, irrigation, municipal, industrial)			
<b>WELL COMPLETION DATA:</b>			
(1) diameter (inches) <u>4</u>			
(2) total depth (feet) <u>123</u>			
(3) static water level (feet) <u>33</u> below top of ground.			
(4) casing <u>PVC</u> , <u>113'</u> (material) (depth) <u>4"</u> (size) if telescope see back.			
(5) screen <u>10'</u> , <u>113'</u> (length) (depth to top) <u>.010</u> <u>PVC</u> (size) (material)			
(6) pump <u>did not install</u> (HP) (yield gpm)  (type power)			
(7) electric log <u>no</u> (yes or no)  (organization running log)			
(8) how well bottom plugged _____ <u>back wash valve</u>			

DEPARTMENT OF NATURAL RESOURCES  
BUREAU OF LAND AND WATER RESOURCES  
APR - 6 1986

DRILLERS REMARKS: \_\_\_\_\_  
Department of Natural Resources  
Bureau of Land and Water Resources

If well telescopes please sketch and show depths.

GROUND LEVEL

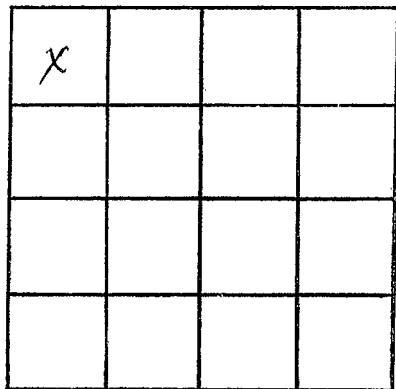

SECTION 16

Please indicate well location X.

ADDITIONAL INFORMATION

If more than one screen,  
show locations of each on sketch.