

MISSISSIPPI DEPARTMENT OF NATURAL RESOURCES

Bureau of Land and Water Resources

Southport Mall

P.O. Box 10631

Jackson, Mississippi 39209

WATER WELL DRILLERS LOG

PIKE
A 2042

1-12
date well completed

1987

Fitzgerald Well Sew
firm name

Pike
county well located

LANDOWNER:	description of formations encountered	from	to
Linda Craft. R.R. Summit, ms. (mailing address)	Red clay Red sand Coarse sand & gravel	0 20 35	20 35 60
WELL LOCATION: sec. 36 T 4 N R 7 E S W 1/4 miles S of Summit (distance) (direction) (nearest town)			
WELL PURPOSE: Home (home, irrigation, municipal, industrial)			
WELL COMPLETION DATA: (1) diameter (inches) 4 (2) total depth (feet) 60 (3) static water level (feet) 14 below above top of ground. (4) casing PVC, 50 (material) (depth), 4 (size) if telescope see back. (5) screen 10 (length), 50 (depth to top), 4 (size), PVC (material) (6) pump 1/2 (HP), 10 (yield gpm), Elec (type power) (7) electric log No (yes or no) (organization running log) (8) how well bottom plugged Sand plug			

RECEIVED


FEB 12 1987

Department of Natural Resources
Bureau of Land & Water Resources

DRILLERS REMARKS:

If well telescopes please sketch and show depths.

GROUND LEVEL

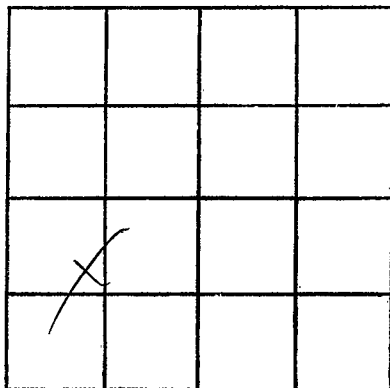

SECTION 36

Please indicate well location X.

ADDITIONAL INFORMATION

If more than one screen,
show locations of each on sketch.