

Pine  
A2055

MISSISSIPPI DEPARTMENT OF NATURAL RESOURCES  
Bureau of Land and Water Resources  
Southport Mall  
P.O. Box 10631  
Jackson, Mississippi 39209  
WATER WELL DRILLERS LOG

10-2 1990 Fitzgerald well Inc Pine  
date well completed firm name county well located

LANDOWNER:	description of formations encountered	from	to
<u>Al Bristle</u>			
<u>Bk - Summit ms.</u> (mailing address)	<u>Red clay</u>	<u>0</u>	<u>20</u>
	<u>Red sand</u>	<u>20</u>	<u>60</u>
	<u>Coarse sand &amp; gravel</u>	<u>60</u>	<u>80</u>
WELL LOCATION: sec. <u>16</u> T <u>4</u> N R <u>7</u> E S W <u>2</u> miles <u>E</u> of <u>Summit</u> (distance) (direction) (nearest town)			
WELL PURPOSE: (home, irrigation, municipal, industrial)			
WELL COMPLETION DATA:			
(1) diameter (inches) <u>4</u>			
(2) total depth (feet) <u>80</u>			
(3) static water level (feet) <u>51</u> below above top of ground.			
(4) casing <u>PVC</u> , <u>70</u> (material) (depth) <u>4</u> (size) if telescope see back.			
(5) screen <u>10</u> , <u>70</u> (length) (depth to top) <u>4</u> , <u>PVC</u> (size) (material)			
(6) pump <u>1/2</u> <u>10</u> (HP) (yield gpm) <u>elec</u> (type power)			
(7) electric log <u>yes</u> (yes or no) <u></u> (organization running log)			
(8) how well bottom plugged <u>see log</u>			
DRILLERS REMARKS:			


RECEIVED

NOV 27 1990

Department of Natural Resources  
Bureau of Land & Water Resources

If well telescopes please sketch and show depths.

GROUND LEVEL

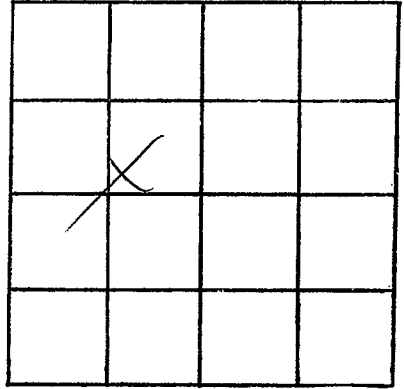

SECTION 16

Please indicate well location X.

ADDITIONAL INFORMATION

If more than one screen,  
show locations of each on sketch.