

MISSISSIPPI DEPARTMENT OF ENVIRONMENTAL QUALITY

Office of Land and Water Resources

P. O. Box 10631
Jackson, MS 39289-0631

WATER WELL DRILLERS LOG

COUNTY WELL LOCATED <i>Pike</i>	
WELL NUMBER <i>A</i>	CODED
DATE WELL COMPLETED <i>2059 July 16, 94</i>	

PERMIT NUMBER
NAME OF DRILLING FIRM <i>F. TIGER BLOW WELLS</i>

NAME & MAILING ADDRESS OF LANDOWNER <i>Dyle Hagman R.R. Summit ms</i>			
WELL LOCATION:	SEC	TOWNSHIP	RANGE
	<i>23</i>	<i>4</i>	<i>N 7 E</i>
DISTANCE	DIRECTION	NEAREST TOWN	
<i>1/2</i> Miles	<i>NW</i>	of <i>Summit</i>	
OTHER LANDMARK			
WELL PURPOSE: Home, Irrigation, Municipal, Industrial, Fish Pond, etc. <i>Home</i>			

PUMP DATA			
PUMP TYPE (Circle One): <input checked="" type="radio"/> Submersible, <input type="radio"/> Turbine, <input type="radio"/> Jet, <input type="radio"/> Flowing Well, Other (Describe) _____			
POWER TYPE (Circle One): <input checked="" type="radio"/> Electric, <input type="radio"/> Tractor, <input type="radio"/> Diesel, <input type="radio"/> Gasoline, <input type="radio"/> Butane, Other (Describe) _____ H/P <i>3/4</i>			
Pump Capacity (GPM)	No. of Stages	Setting Depth	
<i>15</i>	<i>12</i>	<i>80</i> FT.	
PUMP TEST			
Well yielded _____ <i>20</i> GPM with			
a drawdown of _____ <i>2</i> ft.			
after _____ <i>2</i> hours of pumping			

Well Depth <i>100</i>	Casing Diameter (In.) <i>4</i>	Casing Length (Ft.) <i>90</i>
Type of Casing <i>PVC</i>	Hole Depth <i>100</i>	Depth to Static Water Level <i>48</i>

LOG DATA	
TYPE OF LOG RUN (Circle One): <input checked="" type="radio"/> No Log Run, <input type="radio"/> Electric, <input type="radio"/> Gamma Ray, <input type="radio"/> Density, <input type="radio"/> Sonic, <input type="radio"/> Neutron, Other (Describe) _____	
Name of Organization Running Log	

TYPE OF COMPLETION: (Circle One or More):
 Gravel Paiked, Underreamed, Telescoped,
 Natural Development, Open Hole, Other

GEOLOGIC DATA (Office Use Only)			
Surface Elev.	Geologic Unit	Unit Thickness	Depth to Top
Subs. SW	Date	Analysis	Acquifer Test

WELL GROUTED TO A DEPTH OF *10* FEET
Type Grout (circle one): Cement, Bentonite, or *Mix*

SCREEN DATA		
Diameter - Inches <i>4</i>	Length - Feet <i>10</i>	Slot Size - Inches <i>10/32</i>
Screen Type <i>AWE</i>	Depth to Bottom - Feet <i>100</i>	

Driller's Remarks	JUL 27 1994
Dept. of Environmental Quality Office of Land and Water Resources	
FEET	IF TELESCOPED OR MORE THAN ONE SCREEN: USE BACK PAGE


DESCRIPTION OF FORMATIONS ENCOUNTERED	FROM	TO
<i>Red Clay</i>	<i>0</i>	<i>20</i>
<i>Red Sand</i>	<i>20</i>	<i>79</i>
<i>Coarse Sand Gravel</i>	<i>79</i>	<i>100</i>

FORMATIONS (Continued)	FROM	TO

IF MORE SPACE IS NEEDED, USE BACK

If well telescopes please sketch and show depths.

GROUND LEVEL

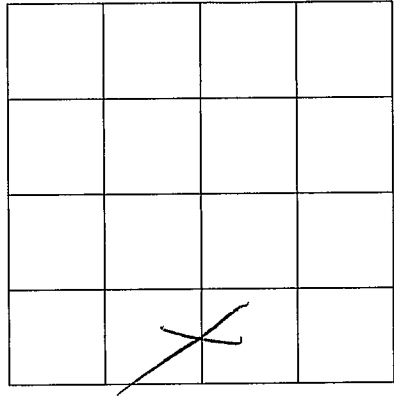

SECTION 22

Please indicate well location X.

ADDITIONAL INFORMATION

If more than one screen,
show location of each on sketch.