

MISSISSIPPI DEPARTMENT OF ENVIRONMENTAL QUALITY

Office of Land and Water Resources

P. O. Box 10631
Jackson, MS 39289-0631

WATER WELL DRILLERS LOG

COUNTY WELL LOCATED
Pike

WELL NUMBER A CODED

DATE WELL COMPLETED
JUNE 16 94

PERMIT NUMBER

NAME OF DRILLING FIRM
F. LAGERMAN Well Serv

NAME & MAILING ADDRESS OF LANDOWNER
E.C. PARKER
P.O. Box McComb ms

WELL LOCATION: SEC 2 TOWNSHIP 4 RANGE N 7 E
S W

DISTANCE 1 1/4 Miles west of McComb

OTHER LANDMARK

WELL PURPOSE: Home, Irrigation, Municipal, Industrial, Fish Pond, etc.
Irrigation

PUMP DATA

PUMP TYPE (Circle One):
Submersible Turbine, Jet, Flowing Well,
Other (Describe)

POWER TYPE (Circle One):
Electric Tractor, Diesel, Gasoline, Butane,
Other (Describe) H/P

Pump Capacity (GPM) 20 No. of Stages 10 Setting Depth 80 FT.

PUMP TEST
Well yielded 40 GPM with
a drawdown of 2 ft.
after 2 hours of pumping

WELL DATA

Well Depth 90 Casing Diameter (In.) 4 Casing Length (Ft.) 80

Type of Casing P/C Hole Depth 90 Depth to Static Water Level 57

LOG DATA

TYPE OF LOG RUN (Circle One): No Log Run,
Electric, Gamma Ray, Density, Sonic, Neutron,
Other (Describe)

Name of Organization Running Log

TYPE OF COMPLETION: (Circle One or More):
Gravel Packed, Underreamed, Telescoped,
Natural Development, Open Hole, Other

WELL GROUTED TO A DEPTH OF 10 FEET
Type Grout (circle one): Cement, Bentonite, or Mix

GEOLOGIC DATA (Office Use Only)

Surface Elev.	Geologic Unit	Unit Thickness	Depth to Top
Subs. Well	Analysis	Aquifer Test	

Driller's Remarks

SCREEN DATA

Diameter - Inches 4 Length - Feet 10 Slot Size - Inches 10/32

Screen Type PC Depth to Bottom - Feet 90

JUL 27 1994

Top of Lap Pipe or Gravel in Casing
DEPT. OF ENVIRONMENTAL QUALITY
Office of Land & Water Resources


IF TELESCOPED OR MORE THAN ONE SCREEN: USE BACK PAGE

DESCRIPTION OF FORMATIONS ENCOUNTERED	FROM TO		FORMATIONS (Continued)	FROM TO	
<u>Red Clay</u>	<u>0</u>	<u>20</u>			
<u>Red Sand</u>	<u>20</u>	<u>76</u>			
<u>Course Sandstone</u>	<u>76</u>	<u>90</u>			

IF MORE SPACE IS NEEDED, USE BACK

If well telescopes please sketch and show depths.

GROUND LEVEL

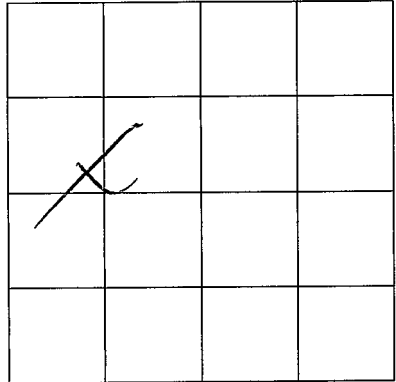

SECTION 2

Please indicate well location X.

ADDITIONAL INFORMATION

If more than one screen,
show location of each on sketch.