

MISSISSIPPI DEPARTMENT OF ENVIRONMENTAL QUALITY

Office of Land and Water Resources

P. O. Box 10631
Jackson, MS 39289-0631
WATER WELL DRILLERS LOG

COUNTY, WELL LOCATED <i>Dike</i>	
WELL NUMBER <i>A</i>	CODED
DATE WELL COMPLETED <i>2001 JULY 25, 94</i>	

PERMIT NUMBER
NAME OF DRILLING FIRM <i>F. F. GERMAN Well Service</i>

NAME & MAILING ADDRESS OF LANDOWNER <i>Don Alford</i>		
WELL LOCATION: SEC <u>31</u> TOWNSHIP <u>4</u> RANGE <u>7</u> <i>N S E W</i>		
DISTANCE <u>1</u> Miles	DIRECTION <u>S</u>	NEAREST TOWN <u>Summit</u>
OTHER LANDMARK		
WELL PURPOSE: Home, Irrigation, Municipal, Industrial, Fish Pond, etc. <i>Home</i>		

PUMP DATA		
PUMP TYPE (Circle One): <input checked="" type="radio"/> Submersible, <input type="radio"/> Turbine, <input type="radio"/> Jet <input type="radio"/> Flowing Well, Other (Describe) _____		
POWER TYPE (Circle One): <input checked="" type="radio"/> Electric, <input type="radio"/> Tractor, <input type="radio"/> Diesel, <input type="radio"/> Gasoline, <input type="radio"/> Butane, Other (Describe) _____ H/P <u>3/4</u>		
Pump Capacity (GPM) <u>12</u>	No. of Stages <u>12</u>	Setting Depth <u>80</u> FT.
PUMP TEST		
Well yielded <u>25</u> GPM with a drawdown of <u>2</u> ft. after <u>2</u> hours of pumping		

WELL DATA		
Well Depth <u>95</u>	Casing Diameter (In.) <u>4</u>	Casing Length (Ft.) <u>85</u>
Type of Casing <u>POC</u>	Hole Depth <u>95</u>	Depth to Static Water Level <u>40</u>

LOG DATA	
TYPE OF LOG RUN (Circle One): <input checked="" type="radio"/> No Log Run, <input type="radio"/> Electric, <input type="radio"/> Gamma Ray, <input type="radio"/> Density, <input type="radio"/> Sonic, <input type="radio"/> Neutron, Other (Describe) _____	
Name of Organization Running Log	

TYPE OF COMPLETION: (Circle One or More): <input checked="" type="radio"/> Gravel Packed, <input type="radio"/> Underreamed, <input type="radio"/> Telescoped, <input type="radio"/> Natural Development, <input type="radio"/> Open Hole, <input type="radio"/> Other (Describe) _____	
--	--

GEOLOGIC DATA (Office Use Only)			
Surface Elev.	Geologic Unit	Unit Thickness	Depth to Top
Subs. SWL	Date	Analysis	Aquifer Test

WELL GROUTED TO A DEPTH OF <u>10</u> FEET Type Grout (circle one): Cement, Bentonite, <u>or Mix</u>
--

Driller's Remarks
Top of Lap Pipe or Reduction in Casing
FEET <input type="checkbox"/> IF TELESCOPED OR MORE THAN ONE SCREEN: USE BACK PAGE


SCREEN DATA		
Diameter - Inches <u>4</u>	Length - Feet <u>10</u>	Slot Size - Inches <u>.012</u>
Screen Type <u>D3C</u>	Depth to Bottom - Feet <u>95</u>	

DESCRIPTION OF FORMATIONS ENCOUNTERED	FROM	TO
<i>Red Clay</i>	<u>0</u>	<u>20</u>
<i>Red Sand</i>	<u>20</u>	<u>60</u>
<i>Coarse Sand & gravel</i>	<u>60</u>	<u>95</u>

FORMATIONS (Continued)	FROM	TO
RECEIVED		
OCT 14 1994		
Dept. of Environmental Quality Office of Land & Water Resources		
IF MORE SPACE IS NEEDED, USE BACK		

If well telescopes please sketch and show depths.

GROUND LEVEL

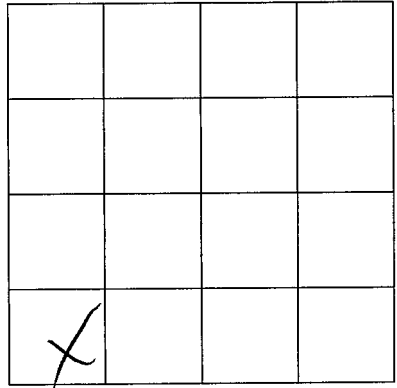

SECTION 31

Please indicate well location X.

ADDITIONAL INFORMATION

If more than one screen,
show location of each on sketch.