

**MISSISSIPPI DEPARTMENT OF ENVIRONMENTAL QUALITY**

Office of Land and Water Resources

P. O. Box 10631  
Jackson, MS 39289-0631  
**WATER WELL DRILLERS LOG**

COUNTY WELL LOCATED <i>Pike</i>	
WELL NUMBER <i>A</i>	CODED
DATE WELL COMPLETED <i>2002 Oct 4-94</i>	

PERMIT NUMBER
NAME OF DRILLING FIRM <i>FitzGERALD Well Serv</i>

NAME & MAILING ADDRESS OF LANDOWNER <i>Seago Lumber Co</i> <i>P.O. Box 11606, m</i>			
WELL LOCATION:	SEC	TOWNSHIP	RANGE
	<i>14</i>	<i>4</i>	<i>N 7 E</i>
DISTANCE	DIRECTION	NEAREST TOWN	
<i>1.4</i> Miles	<i>W</i>	<i>of McComb</i>	
OTHER LANDMARK			
WELL PURPOSE: Home, Irrigation, Municipal, Industrial, Fish Pond, etc. <i>Irrigation - Logs</i>			

PUMP DATA			
PUMP TYPE (Circle One): <u>Submersible</u> , Turbine, Jet, Flowing Well, Other (Describe)			
POWER TYPE (Circle One): <u>Electric</u> , Tractor, Diesel, Gasoline, Butane, Other (Describe) H/P <i>5</i>			
Pump Capacity (GPM)	No. of Stages	Setting Depth	
<i>80</i>	<i>10</i>	<i>126</i> FT.	
PUMP TEST			
Well yielded <i>100</i> GPM with a drawdown of <i>4</i> ft. after <i>2</i> hours of pumping			

WELL DATA		
Well Depth <i>248</i>	Casing Diameter (In.) <i>4</i>	Casing Length (Ft.) <i>228</i>
Type of Casing <i>POC</i>	Hole Depth <i>248</i>	Depth to Static Water Level <i>43</i>

LOG DATA	
TYPE OF LOG RUN (Circle One): <u>No Log Run</u> , Electric, Gamma Ray, Density, Sonic, Neutron, Other (Describe)	
Name of Organization Running Log	


TYPE OF COMPLETION: (Circle One or More): <u>Gravel Packed</u> , Underreamed, Telescoped, Natural Development, Open Hole, Other (Describe)			
WELL GROUTED TO A DEPTH OF <i>10</i> FEET Type Grout (circle one): Cement, Bentonite, <u>Mix</u>			

GEOLOGIC DATA (Office Use Only)			
Surface Elev.	Geologic Unit	Unit Thickness	Depth to Top
Subs. SWL	Date	Analysis	Aquifer Test

SCREEN DATA		
Diameter - Inches <i>4</i>	Length - Feet <i>20</i>	Slot Size - Inches <i>.012</i>
Screen Type <i>POC</i>	Depth to Bottom - Feet <i>248</i>	


Driller's Remarks	
Top of Lap Pipe or Reduction in Casing	
FEET	IF TELESCOPED OR MORE THAN ONE SCREEN: USE BACK PAGE

DESCRIPTION OF FORMATIONS ENCOUNTERED	FROM	TO
<i>BARK &amp; Red Clay</i>	<i>0</i>	<i>20</i>
<i>Fine SAND &amp; gravel</i>	<i>20</i>	<i>81</i>
<i>White chalk</i>	<i>81</i>	<i>215</i>
<i>Coarse Sand &amp; gravel</i>	<i>215</i>	<i>248</i>

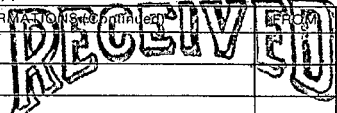 <b>OCT 14 1994</b>	
Dept. of Environmental Quality Office of Land & Water Resources	
IF MORE SPACE IS NEEDED, USE BACK	

If well telescopes please  
sketch and show depths.

GROUND LEVEL

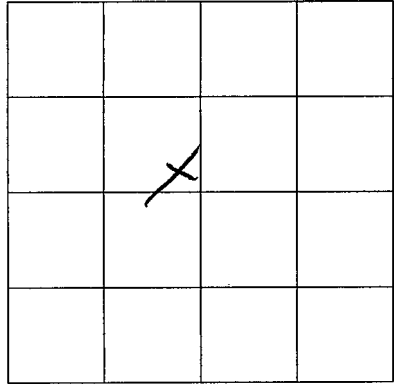

SECTION 14

Please indicate well location X.

ADDITIONAL INFORMATION

If more than one screen,  
show location of each on sketch.