

MISSISSIPPI DEPARTMENT OF ENVIRONMENTAL QUALITY

Office of Land and Water Resources

P. O. Box 10631
Jackson, MS 39289-0631
WATER WELL DRILLERS LOG

COUNTY WELL LOCATED PERNET PIKE		
WELL NUMBER 3 A	CODED 2067	PERMIT NUMBER 0519
NAME OF DRILLING FIRM BURGE WELL SERVICE		
DATE WELL COMPLETED 1-7-76		

NAME & MAILING ADDRESS OF LANDOWNER
Keith Sanders
Bus supply CO. McComb
McComb, MS.

WELL LOCATION: SEC 14 TOWNSHIP 4 S RANGE 7 E

DISTANCE 2 Miles DIRECTION NORTH of NEAREST TOWN McCombms

OTHER LANDMARK
McComb MS.

WELL PURPOSE: Home, Irrigation, Municipal, Industrial, Fish Pond, etc.
FILL FISH POND

PUMP DATA

PUMP TYPE (Circle One):
Submersible, Turbine, Jet, Flowing Well,
Other (Describe) _____

POWER TYPE (Circle One):
Electric, Tractor, Diesel, Gasoline, Butane,
Other (Describe) _____ H/P _____

Pump Capacity (GPM) 80 No. of Stages 8 Setting Depth 110 FT.

PUMP TEST
Well yielded _____ GPM with
a drawdown of _____ ft.
after _____ hours of pumping

WELL DATA

Well Depth 120'	Casing Diameter (In.) 4	Casing Length (Ft.) 120'
Type of Casing PVC	Hole Depth 122'	Depth to Static Water Level 60'

TYPE OF COMPLETION: (Circle One or More):
Gravel Packed, Underreamed, Telescoped,
Natural Development, Open Hole, Other
(Describe) _____

WELL GROUTED TO A DEPTH OF _____ FEET
Type Grout (circle one): Cement, Bentonite, or Mix

SCREEN DATA

Diameter - Inches 4	Length - Feet 20'	Slot Size - Inches #12
Screen Type SLOT	Depth to Bottom - Feet 120'	

LOG DATA

TYPE OF LOG RUN (Circle One): No Log Run,
Electric, Gamma Ray, Density, Sonic, Neutron,
Other (Describe) _____

Name of Organization Running Log _____

GEOLOGIC DATA (Office Use Only)

Surface Elev.	Geologic Unit	Unit Thickness	Depth to Top
Subs. SWL	Date	Analysis	Aquifer Test

Driller's Remarks

Top of Lap Pipe or Reduction in Casing _____ FEET
IF TELESCOPED OR MORE THAN ONE SCREEN USE BACK PAGE


DESCRIPTION OF FORMATIONS ENCOUNTERED	FROM	TO	FROM	TO
BLACK DIRT	0	5		
SAND	5	15		
CLAY	15	25		
RED CLAY	25	35		
WHITE CLAY	35	65		
SAND	65	120		

MAR 14 1995

Dept. of Environmental Quality
Office of Land & Water Resources

If well telescopes please sketch and show depths.

GROUND LEVEL

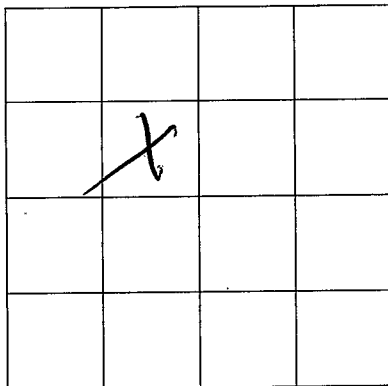

SECTION _____

Please indicate well location X.

ADDITIONAL INFORMATION

If more than one screen,
show location of each on sketch.