

# MISSISSIPPI DEPARTMENT OF NATURAL RESOURCES

Bureau of Land and Water Resources

P.O. Box 10631

Jackson, Mississippi 39209

## WATER WELL DRILLERS LOG

COUNTY WELL LOCATED <b>Pike</b>	
WELL NUMBER <b>236180</b>	CODED
<b>A 2073</b>	
DATE WELL COMPLETED <b>3-18-97</b>	

PERMIT NUMBER <b>510</b>
NAME OF DRILLING FIRM <b>Easley Water Wells</b>
<b>Brookhaven, MS 39601</b>

NAME & MAILING ADDRESS OF LANDOWNER <b>William Freeman</b>			
WELL LOCATION:	SEC.	TOWNSHIP	RANGE
	<b>4</b>	<b>40</b>	<b>7E</b>
		<b>S</b>	<b>W</b>
DISTANCE	DIRECTION	NEAREST TOWN	
_____ Miles	_____ of _____	_____	
OTHER LANDMARK			
WELL PURPOSE: Home, Irrigation, Municipal, Industrial, Fish Pond, etc.			

<b>PUMP DATA</b>		
PUMP TYPE (Circle One): <u>Submersible</u> Turbine, Jet, Flowing Well, Other (Describe) _____		
POWER TYPE (Circle One): <u>Electric</u> Tractor, Diesel, Gasoline, Butane, Other (Describe) _____		
Pump Capacity (GPM)	No. of Stages	Setting Depth  <b>FT.</b>
PUMP TEST		
Well yielded _____ GPM with a drawdown of _____ ft. after _____ hours of pumping		

<b>WELL DATA</b>		
Well Depth <b>65'</b>	Casing Diameter (In.) <b>4"</b>	Casing Length (Ft.) <b>45'</b>
Type of Casing <b>PVC</b>	Hole Depth <b>80'</b>	Depth to Static Water Level
TYPE OF COMPLETION: (Circle One or More): <u>Natural Development</u> , Gravel Packed, Underreamed, Telescoped, Open Hole, Other		
Top of Lap Pipe or Reduction in Casing  <b>FEET</b> IF TELESCOPED OR MORE THAN ONE SCREEN: USE BACK PAGE		

<b>LOG DATA</b>	
TYPE OF LOG RUN (Circle One): <u>Electric</u> , No Log Run, Gamma Ray, Density, Sonic, Neutron, Other (Describe) _____	
Name of Organization Running Log	

<b>SCREEN DATA</b>		
Diameter - Inches <b>4"</b>	Length - Feet <b>20'</b>	Slot Size - Inches <b>12</b>
Screen Type <b>PVC</b>	Depth to Bottom - Feet <b>65'</b>	

<b>GEOLOGIC DATA (Office Use Only)</b>			
Surface Elev.	Geologic Unit	Unit Thickness	Depth to Top
Subs. SWL	Date	Analysis	Aquifer Test

Driller's Remarks


DESCRIPTION OF FORMATIONS ENCOUNTERED	FROM	TO	FORMATIONS (Continued)	FROM	TO
Clay	0	10	<div style="font-size: 2em; opacity: 0.5; transform: rotate(-15deg); display: inline-block;">RECEIVED</div>  <div style="font-size: 1.5em; font-weight: bold;">AUG 19 1997</div>		
Gravel	10	40			
Sand	40	65			
Clay	65	80			
			Dept. of Environmental Quality Office of Land & Water Resources		
IF MORE SPACE IS NEEDED, USE BACK					

If well telescopes please  
sketch and show depths.

---

GROUND LEVEL

---

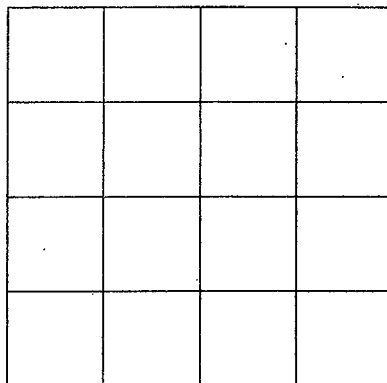

SECTION \_\_\_\_\_

Please indicate well location X.

---

ADDITIONAL INFORMATION

---

If more than one screen,  
show location of each on sketch.

---