

MISSISSIPPI DEPARTMENT OF ENVIRONMENTAL QUALITY

Office of Land and Water Resources

P. O. Box 10631

Jackson, MS 39289-0631

WATER WELL DRILLERS LOG

COUNTY WELL LOCATED	
Pike	
WELL NUMBER	CODED
A-2018	
DATE WELL COMPLETED	
9-13-02	

PERMIT NUMBER
NAME OF DRILLING FIRM
Stegard Well Service

NAME & MAILING ADDRESS OF LANDOWNER			
Rob Kistler			
Hwy 570 Summit			
Latitude:			
Longitude:			
WELL LOCATION	SEC	TOWNSHIP	RANGE
	32	4 ^N _S	7 ^E _W
DISTANCE	DIRECTION	NEAREST TOWN	
3	Miles West	of M ^c Comb	
OTHER LANDMARK			
WELL PURPOSE: <input checked="checked" type="radio"/> Home Irrigation, <input type="radio"/> Municipal, <input type="radio"/> Industrial, <input type="radio"/> Fish Pond, etc.			

PUMP DATA		
PUMP TYPE (Circle One):		
<input checked="checked" type="checkbox"/> Submersible	<input type="checkbox"/> Turbine,	<input type="checkbox"/> Jet <input type="checkbox"/> Flowing Well,
Other (Describe)		
POWER TYPE (Circle One):		
<input checked="checked" type="checkbox"/> Electric	<input type="checkbox"/> Tractor,	<input type="checkbox"/> Diesel, <input type="checkbox"/> Gasoline 1/2
Other (Describe)		H/P 1/2
DESCRIPTION OF FORMATIONS ENCOUNTERED	FROM	TO
clay	0	20
Sand / gravel	20	60
sand	60	80
clay	80	90
Sand	90	100
course sand / gravel	100	117
RECEIVED		
OCT 07 2002		
BY: OLWR		
Top of Lap Pipe or Reduction in Casing		
FEET	IF TELESCOPED OR MORE THAN ONE SCREEN: USE BACK PAGE	

WELL DATA		
Well Depth	Casing Diameter (In.)	Casing Length (Ft.)
117'	4"	107'
Type of Casing	Hole Depth	Depth to Static Water Level
Pvc	117	68'
TYPE OF COMPLETION: (Circle One or More):		
<input checked="checked" type="checkbox"/> Gravel Packed	<input type="checkbox"/> Underreamed,	<input type="checkbox"/> Telescoped,
<input type="checkbox"/> Natural Development,	<input type="checkbox"/> Open Hole,	<input type="checkbox"/> Other
(Describe)		
WELL GROUTED TO A DEPTH OF 10 FEET		
Type Grout (circle one): Cement, Bentonite, or <input checked="checked" type="checkbox"/> Mix		

SCREEN DATA		
Diameter - Inches	Length - Feet	Slot Size - Inches
4"	10	.012
Screen Type	Depth to Bottom - Feet	
Pvc	117'	

I certify that the well was drilled, constructed and completed in accordance with all applicable Requirements of the Mississippi Department of Environmental Quality and/or the Mississippi Department of Health regulations and state laws.


Brad Stegald 029
Signature of Licensed Driller and License No.

9-13-02
Date

Additional Information Required On Back

If well telescopes please sketch and show depths.

GROUND LEVEL

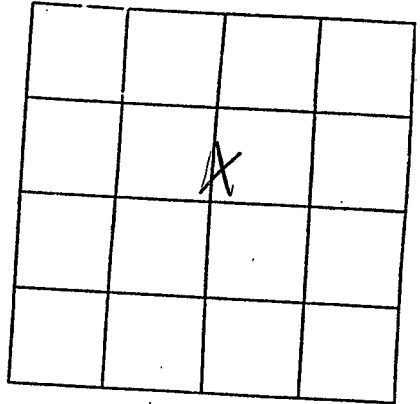

SECTION 32

Please indicate well location X.

Pump Capacity (GPM)	No. of Stages	Setting Depth	
<u>12</u>	<u>8</u>	<u>100</u>	FT.

PUMP TEST

Well yielded _____ GPM with
 a drawdown of _____ ft.
 after _____ hours of pumping

LOG DATA

TYPE OF LOG RUN (Circle One): No Log Run.
 Electric, Gamma Ray, Density, Sonic, Neutron,
 Other (Describe) _____

Name of Organization Running Log _____

GEOLOGIC DATA (Office Use Only)

Surface Elev.	Geologic Unit	Unit Thickness	Depth to Top
Subs. SWL	Date	Analysis	Aquifer Test

Driller's Remarks

If more than one screen,
 show location of each on sketch.